IREDELL COUNTY HEALTH DEPARTMENT

Statesville Phone TR 3-7271 Mooresville Phone No. 664-5281

PERMIT TO INSTALL SEPTIC TANK

Permit No. 401 Permit Date 6-4 1973

Owner James Ladd Address Union Grove

Installed By Henry Norman Address Statesville N.C.


Location of Property 901 to Union Grove, T.R. on Rd 1852. Trailer on R. Near Yadkin County Line.

Tank		Capacity		Length of Lines		Fixtures	
Block	( )	1000	(✓)	225'	(✓)	No. of Baths	( )
Precast	(✓)	1250	( )	250'	( )	Dishwasher	( )
		1500	( )	Other		Garbage Grdr.	( )
		Other				Other	

NOTIFY HEALTH DEPARTMENT AT LEAST EIGHT HOURS BEFORE TANK IS TO BE INSPECTED.

Final Inspection 6-4 1973 Approved (✓) Disapproved ( )

Remarks Well 84' from Tank and Lines

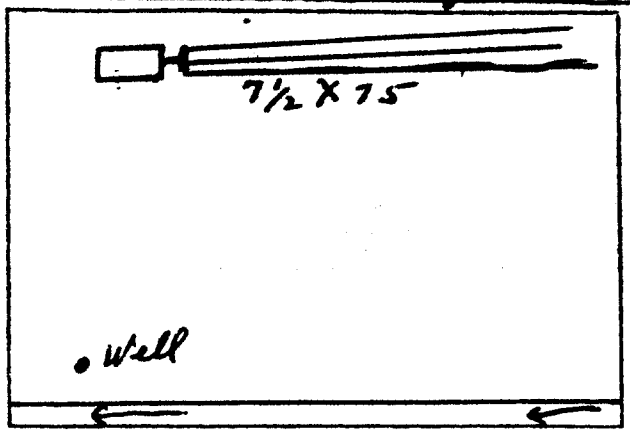

Sketch of Installation

Trailer not on lot at time of inspection.

E. G. Stevenson
Sanitarian