IREDELL COUNTY HEALTH DEPARTMENT

STATESVILLE 704-878-5305 (2) MOORESVILLE 704-664-5281

(1) IMPROVEMENT PERMIT / AUTHORIZATION TO CONSTRUCT / OPERATION PERMIT / EXISTING SYSTEM INSPECTION

PERMIT# 146259 PIN# 4854-31-2845 DATE 11-5-07

OWNER OR APPLICANT STEVEN J. BULLINS PHONE: Business 336-466-1008 Home 336-957-4235

ADDRESS 1783 ROARING GAP CHURCH ROAD, ELKIN NC 28621

LOCATION I-77 N, TL NC 901, TR HOWARD'S BRIDGE ROAD, TR TUTTEROW ROAD, 0.4 MILE ON LEFT

SUBDIVISION _____ BLOCK / SECTION _____ LOT _____ LOT AREA 9 ACRES SITE CLASS. PS DESIGN FLOW 360 L.T.A.R. 0.30 GPD/FT2

Septic Tank: 1000 Gallons; STB 854 Date 8-27-07
Pump Tank: _____ Gallons; PT _____ Date _____
Pump Make: _____ Model _____ Serial No. _____
Nitrification Field: No Fields 1 Square Feet 1200 Linear Feet 400
No Lines FOUR Trench Width 36" Max Trench Bottom Depth 36" Gravel Depth 12"

☑ New System ☐ Repair ☐ Expansion System Type: I (II) III IV V VI
System Description: CONVENTIONAL GRAVITY
Repair System Description: CONVENTIONAL GRAVITY
Maintenance Agreement Required: ☐ Yes ☑ No
☑ Gravity ☐ Pressure

☑ House/Mod. Home No. Bedrooms 3
☐ Mobile Home No. Persons ____
☐ Business No. Employees ____
☐ Other _____


☐ Slab ☐ Crawl Space ☐ Basement w/plumbing ☑ Basement wo/plumbing

Water Supply: ☑ Individual ☐ Public ☐ Community WELL


Comments:/Conditions: AN "ACCEPTED" SYSTEM MAY ALSO BE USED.

Comments:/Conditions: P.L. 1180' (3) SEPTIC TANK WITH RSF POLY LOK FILTER & MARKER INSTALLED (2) HOUSE BUILT ON CRAWL SPACE INSTEAD OF BASEMENT

INITIAL SITE SKETCH

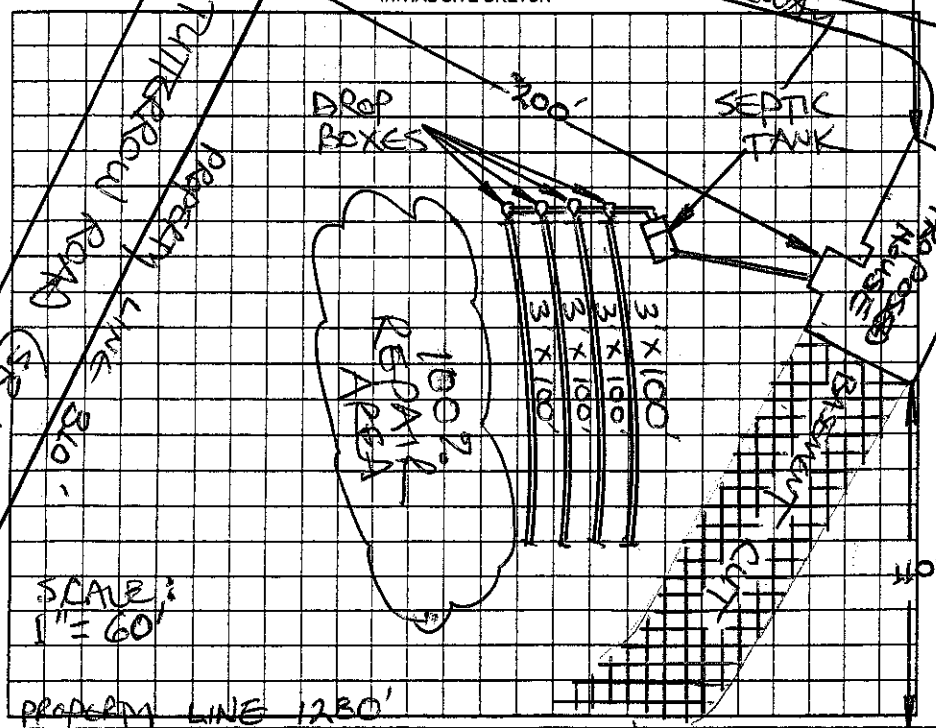

AS BUILT SKETCH

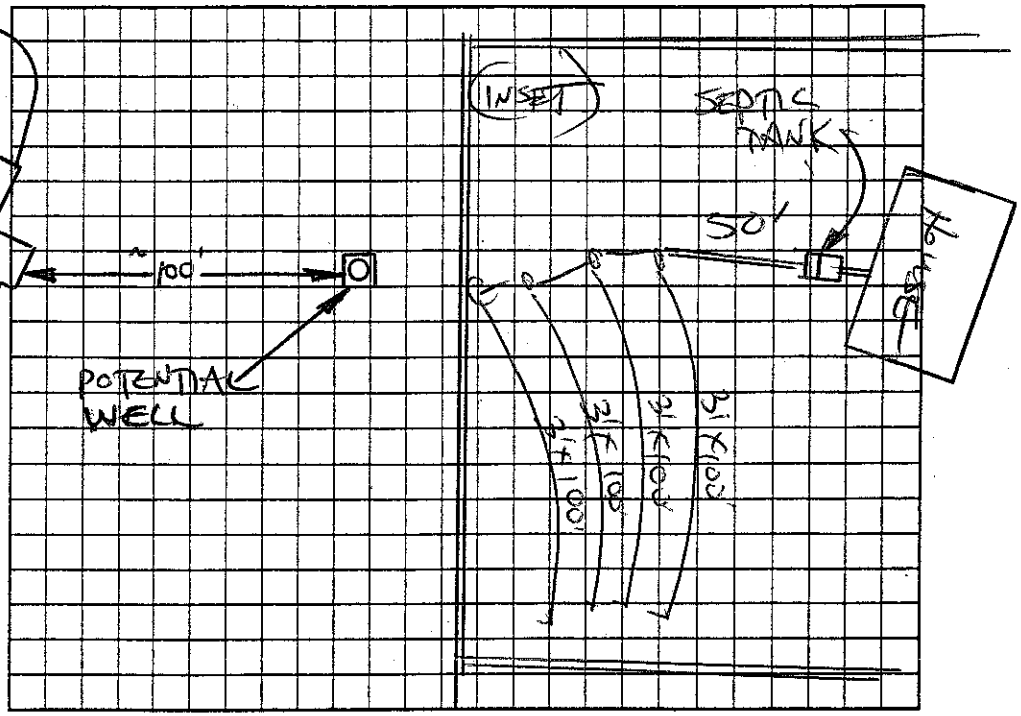

Permit can be suspended or revoked if any false information is supplied toward securing the permit/any unauthorized changes are made to the site/any unauthorized changes are made in the installation of the system. Improvement Permit with plat valid without expiration ☐ Improvement Permit with site plan valid for sixty months ☑ Authorization to Construct is valid for a period equal to that of Improvement Permit – not to exceed sixty months.

Signed: Steven J. Bullins date 11-5-07 Installed by: STEVEN J. BULLINS

Improvement Permit by: STEVE HEDRICK date 11-05-07 Operation Permit by: STEVE HEDRICK date 11-29-07

Authorization to Construct by: STEVE HEDRICK date 11-05-07 Existing System Inspection by: _____ date _____

HEALTH DEPT. COPY: WHITE OWNER COPY (FINAL): YELLOW OWNER COPY (INITIAL): PINK