IREDELL COUNTY HEALTH DEPARTMENT

STATESVILLE 704-878-5305 MOORESVILLE 704-664-5281

IMPROVEMENT PERMIT / AUTHORIZATION TO CONSTRUCT / OPERATION PERMIT / EXISTING SYSTEM INSPECTION

PERMIT# 089891 PIN# 4854 31 5722 DATE June 16, 2000

OWNER OR CONTRACTOR James D. Keller PHONE: Business 876-9092 Home

ADDRESS 182 Rhodes Dr. Statesville 28625

LOCATION 901 Turn on Howard Bridge Road TR Tultscow Rd. ½ mile on left

SUBDIVISION BLOCK / SECTION LOT LOT AREA 9 Acres SITE CLASS PS DESIGN FLOW 360gpd. L.T.A.R. .3 gal/sq ft/day

Septic Tank: 1000 Gallons; STB 1012 Date 2-21-00

Pump Tank: Gallons; PT Date

Pump Make: Model Serial No.

Nitrification Field: No Fields 1 Square Feet 1200 Linear Feet 400

No Lines 5 @ 80' Trench Width 36" Max Trench Bottom Depth 36" Gravel Depth 12"

☑ New System ☐ Repair System Type: I II III IV V VI

System Description: Gravity Conventional

Repair System Description: SAME

Maintenance Agreement Required: ☐ Yes ☑ No

☐ Slab ☑ Crawl Space ☐ Basement w/plumbing ☐ Basement wo/plumbing

☑ House/Mod. Home No. Bedrooms 3

☐ Mobile Home No. Bathrooms 2

☐ Business No. Employees


☐ Other

Water Supply: ☑ Individual ☐ Public ☐ Community


Comments:/Conditions:

Comments:/Conditions: SEPTIC TANK WITH RISERS INSTALLED USING "POLYLOK" FILTER

INITIAL SITE SKETCH

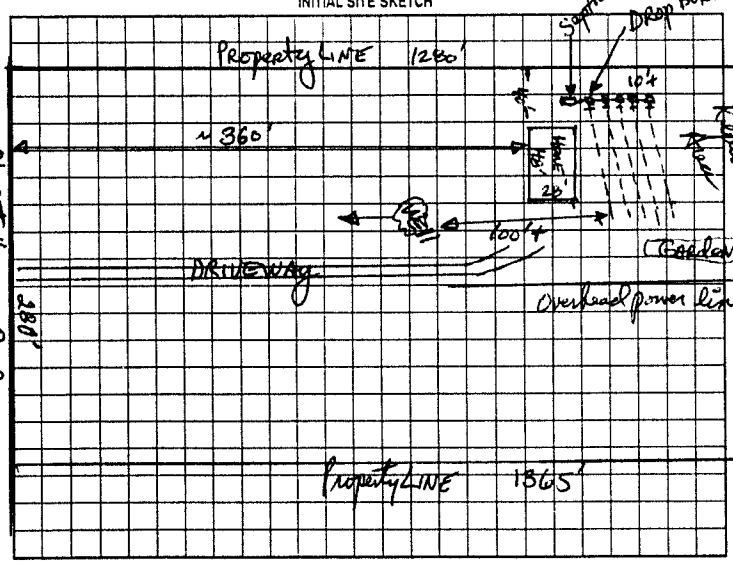

AS BUILT SKETCH

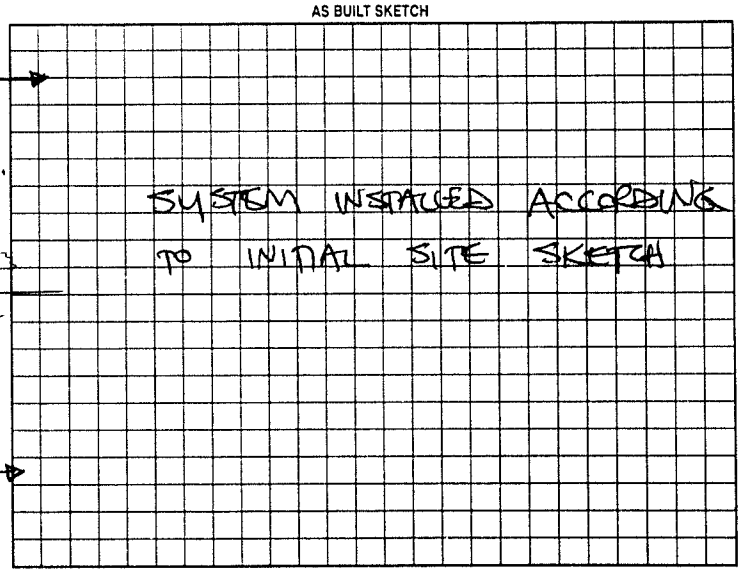

Permit can be suspended or revoked if any false information is supplied toward securing the permit/any unauthorized changes are made to the site/any unauthorized changes are made in the installation of the system. Improvement Permit with plat valid without expiration. Improvement Permit with site plan valid for sixty months. Authorization to Construct is valid for a period equal to that of Improvement Permit – not to exceed sixty months.

Signed: James D. Keller date

Improvement Permit by: [signature] date 6-16-00

Authorization to Construct by: [signature] date 6-16-00

Installed by: A-1 Backhoe

Operation Permit by: Steve Herrick date 6-21-2000

Existing System Inspection by: date

HEALTH DEPT. COPY: WHITE OWNER COPY (FINAL): YELLOW OWNER COPY (INITIAL): PINK