IREDELL COUNTY HEALTH DEPARTMENT

THIS PERMIT VOIDS PREVIOUS ISSUED 5-12-95

STATESVILLE 704-878-5305 MOORESVILLE 704-664-5281

IMPROVEMENT PERMIT / AUTHORIZATION TO CONSTRUCT / OPERATION PERMIT / EXISTING SYSTEM INSPECTION

PERMIT# ~~21060~~ 75076 PIN# 16P-A-24 (PART) DATE 12-16-98

OWNER OR CONTRACTOR KIM C. ALEXANDER PHONE: Business Home 539-5321

ADDRESS 198 MANN ROAD, HARMONY, NC 28634

LOCATION I-77 N, TL NC901, TR IN ION GROVE RD, TL TUTTERROW ROAD, ~500' ON RIGHT, CROSS STREAM 120'


SUBDIVISION BLOCK / SECTION LOT LOT AREA 5 ACRES SITE CLASS PS DESIGN FLOW 360 L.T.A.R. 0.27 GPD/FT²

Septic Tank: 1000 Gallons: STB 1012 Date	✓ New System Repair System Type I II III IV V VI	✓ House/Mod Home No. Bedrooms 3	Water Supply
Pump Tank: 1000 Gallons: PT 17 Date	System Description CHAMBERED, Pump-FED	Mobile Home No. Bathrooms 2	✓ Individual
Pump Make: GOULD'S Model WE0311M Serial No. K9859637	Repair System Description LOW PRESSURE PIPE	Business: No. Employees	Public
Nitrification Field: No. Fields 1 Square Feet Eq. to 1350 Linear Feet 3381	Maintenance Agreement Required Yes ✓ No	Other	Community
No. Lines THREE Trench Width 36" Max. Trench Bottom Depth 30"	~~Curtain Drain~~ Depth SAND 6" Slab Crawl Space ✓ Basement w/plumbing Basement w/o plumbing		WELL

Comments/Conditions: ① INSTALL 54 CHAMBERS (AT REQUEST) IN THREE EQUAL LENGTH LINES ON CONTOUR AS SHOWN ② SEE ATTACHED SHEETS FOR PUMP AND PRESSURE MANIFOLD REQUIREMENTS.

Comments/Conditions: TANKS & LINES INSPECTED 1-12-99 RSH.

INITIAL SITE SKETCH

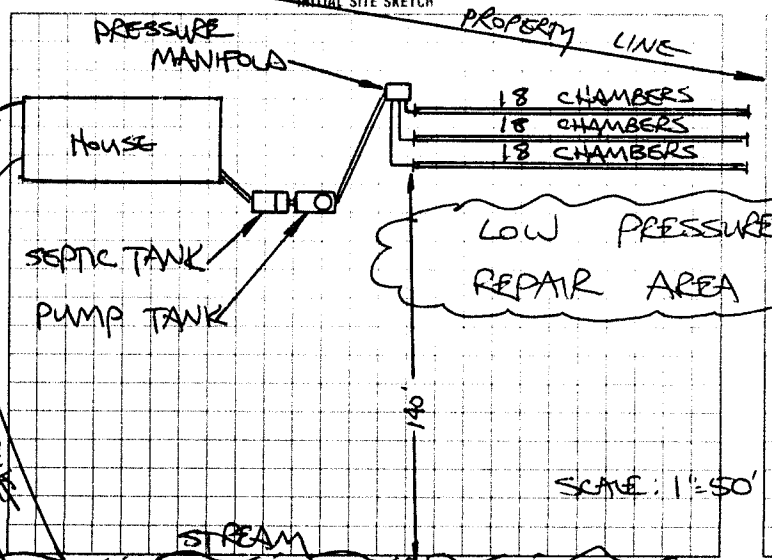

AS BUILT SKETCH

SYSTEM INSTALLED DURING PERIOD OF VERY WET SOIL CONDITIONS.

I understand that this permit can be suspended or revoked if any false information is supplied toward securing the permit/any unauthorized changes are made to the site/any unauthorized changes are made in the installation of the system. Improvement Permit with plat valid without expiration. Improvement Permit with site plan valid for sixty months. Authorization to Construct is valid for a period equal to that of Improvement Permit – not to exceed sixty months.

Signed: [signature] date 12-15-98 Installed by: ARNIE DUNCAN

Improvement Permit by: STEVE HEDRICK date 12-16-98 Operation Permit by: STEVE HEDRICK date 2-12-99

Authorization to Construct by: STEVE HEDRICK date 12-16-98 Existing System Inspection by: date

HEALTH DEPT. COPY: WHITE INSPECTION COPY (FINAL) GREEN OWNER COPY (FINAL) YELLOW INSPECTION COPY (INITIAL) PINK OWNER COPY (INITIAL) GOLD