IREDELL COUNTY HEALTH DEPARTMENT

STATESVILLE 704-878-5305 MOORESVILLE 704-664-5281

IMPROVEMENT PERMIT / CERTIFICATE OF COMPLETION / OPERATION PERMIT / EXISTING SYSTEM INSPECTION

PROPERTY DESCRIPTION NO. 2-2637-039863 DATE 3-23-96 TAX MAP NO. 16P-A-72 Watershed ☒ Yes ☐ No

OWNER OR CONTRACTOR BYRON DEVORE PHONE: Business _____ Home 539-4574

ADDRESS 277 GURNEY ROAD OLIN NC 28660

LOCATION I-77N TL NC901 TR UNION GROVE LOOP ROAD PROPERTY ON LEFT ACROSS FROM HOLLAND FARM RD.

SUBDIVISION PARKS BEND BLOCK / SECTION _____ LOT 3 LOT AREA 4.64 ACRES SITE CLASS PS DESIGN FLOW 480 L.T.A.R. 0.35 GPD/FT²

Septic Tank: 1000 Gallons; STB 1012 Date 8-17-97

Pump Tank _____ Gallons; PT _____ Date _____

Pump Make: _____ Model _____ Serial No. _____

Nitrification Field: No Fields ☐ Square Feet 1380 Linear Feet 460

No Lines 4 Trench Width 36" Max Trench Bottom Depth 18-36 "Gravel Depth 12"

☒ New System ☐ Repair System Type: I II III IV V VI 8

System Description: CONVENTIONAL GRAVITY

Repair System Description: CHANGED GRAVITY

Maintenance Agreement Required Yes ☐ No ☒

Slab ☐ Crawl Space ☒ Basement w/plumbing ☐ Basement wo/plumbing

☐ House/Mod. Home No. Bedrooms 4

☐ Mobile Home No. Bathrooms 2½

☐ Business No. Employees ____


☐ Other _____

Water Supply: ☒ Individual ☐ Community ☐ Public WELL


Comments: ① KEEP SYSTEM MINIMUM 100' FROM WELL, 50' FROM BRANCH 15' FROM BASEMENT FOUNDATION DRAIN ② INSTALL LINES ON CONTOUR, NO DEEPER THAN 36", 9' MINIMUM PART ON CENTERS

Comments:

INITIAL SITE SKETCH

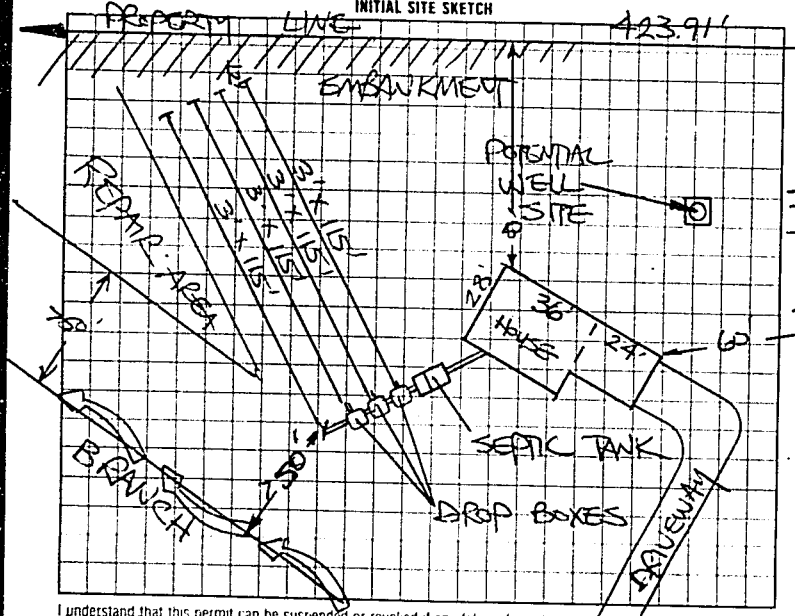

AS BUILT SKETCH

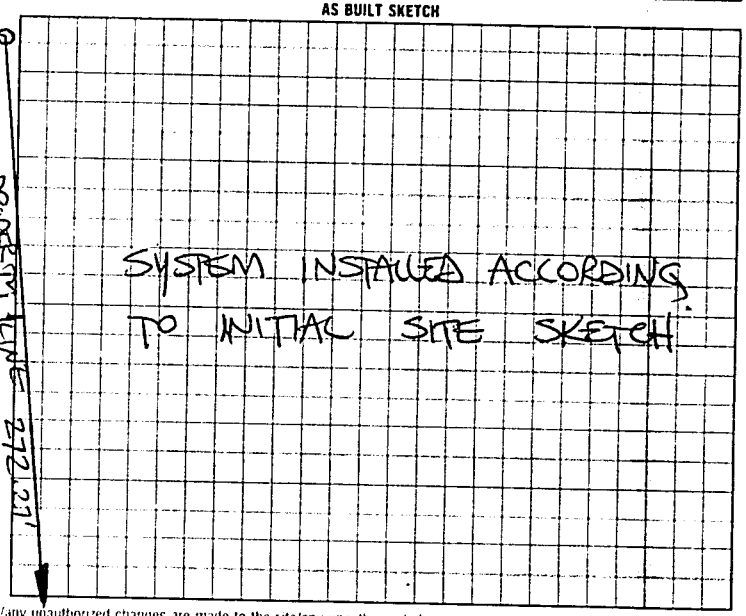

I understand that this permit can be suspended or revoked if any false information is supplied toward securing the permit/any unauthorized changes are made to the site/any unauthorized changes are made in the installation of the system

Authorization to Construct is valid five (5) years from date of issuance. Improvement Permit has no expiration date.

Signed X Byron Devore

Improvement Permit by STEVE HEDRICK date 3-23-96 Installed by A-1 BACKHOE

AUTHORIZATION TO CONSTRUCT: STEVE HEDRICK date 3-23-96 Certificate of Completion by _____ date _____

Operation Permit by STEVE HEDRICK date 11-12-97

OFFICE COPY (FINAL) WHITE — INSPECTION COPY (FINAL) GREEN — OWNER COPY (FINAL) YELLOW — INSPECTION COPY (INITIAL) PINK — OWNER COPY (INITIAL) GOLD