IREDELL COUNTY HEALTH DEPARTMENT

STATESVILLE 704-878-5305 MOORESVILLE 704-664-5281

IMPROVEMENT PERMIT / AUTHORIZATION TO CONSTRUCT / OPERATION PERMIT / EXISTING SYSTEM INSPECTION

PERMIT# 102202 PIN# 4853-80-3751 DATE 9-11-01

OWNER OR CONTRACTOR KATHERINE BOOE PHONE: Business Home (704) 539-4312

ADDRESS 410 ZION LIBERTY ROAD, UNION GROVE, NC 28689

LOCATION I-77N, TL NC901, TR UNION GROVE RD, TR ZION LIBERTY RD, ~0.5 MILE ON LEFT

SUBDIVISION ____ BLOCK / SECTION ____ LOT ____ LOT AREA 2.66 ACRES SITE CLASS P3 DESIGN FLOW 360 L.T.A.R. 0.30 GPD/FT²

Septic Tank: 1000 Gallons; STB 312 Date 10-2-01

Pump Tank: ____ Gallons; PT ____ Date ____

Pump Make: ____ Model ____ Serial No ____

Nitrification Field: No Fields 1 Square Feet 1200 Linear Feet 400

No Lines SIX Trench Width 36" Max Trench Bottom Depth 36" Gravel Depth 12"

☑ New System ☐ Repair System Type: I (II) III IV V VI

System Description: CONVENTIONAL GRAVITY

Repair System Description: CONVENTIONAL GRAVITY

Maintenance Agreement Required: ☐ Yes ☑ No

☑ House/Mod. Home No. Bedrooms 3

☐ Mobile Home No. Bathrooms 2

☐ Business No. Employees ____

☐ Other ____


☐ Slab ☐ Crawl Space ☐ Basement w/plumbing ☐ Basement wo/plumbing

Water Supply: ☑ Individual ☐ Public ☐ Community WELL

Comments/Conditions: 100% REPAIR AREA

Comments/Conditions: SEPTIC TANK WITH MARKER INSTALLED USING "ZABEL" FILTER

INITIAL SITE SKETCH

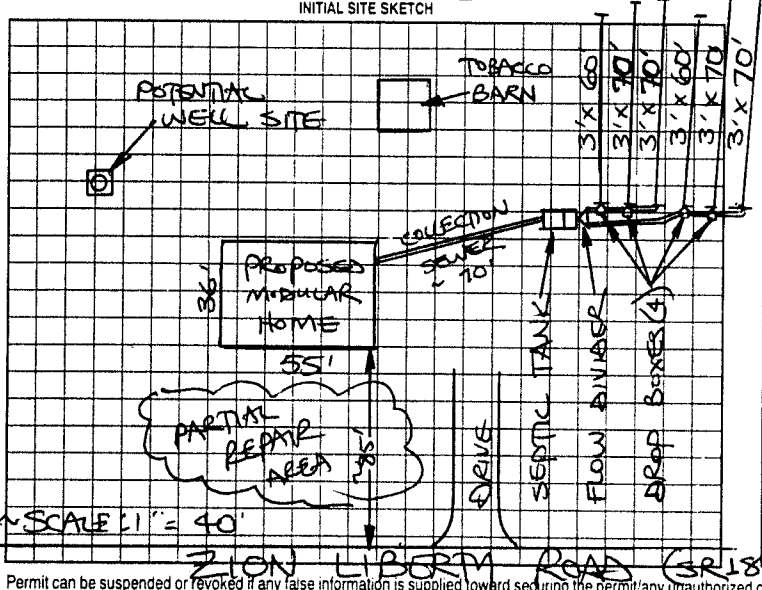

AS BUILT SKETCH

SYSTEM INSTALLED ACCORDING TO INITAL SITE SKETCH

Permit can be suspended or revoked if any false information is supplied toward securing the permit/any unauthorized changes are made to the site/any unauthorized changes are made in the installation of the system. Improvement Permit with plat valid without expiration. Improvement Permit with site plan valid for sixty months. Authorization to Construct is valid for a period equal to that of Improvement Permit – not to exceed sixty months.

Signed: + Katherine Booe date 9-11-01

Improvement Permit by: STEVE HEDRICK date 9-11-01

Authorization to Construct by: STEVE HEDRICK date 9-11-01

Installed by: MARTY TUCKER

Operation Permit by: STEVE HEDRICK date 11-09-01

Existing System Inspection by: ____ date ____

HEALTH DEPT COPY WHITE OWNER COPY (FINAL) YELLOW OWNER COPY (INITIAL) PINK