IREDELL COUNTY HEALTH DEPARTMENT

STATESVILLE 704-878-5305 MOORESVILLE 704-664-5281

IMPROVEMENT PERMIT / CERTIFICATE OF COMPLETION / OPERATION PERMIT / EXISTING SYSTEM INSPECTION

PROPERTY DESCRIPTION NO. 21920 DATE 8-25-95 TAX MAP NO 16P-A-42 Watershed: Yes ✓ No

OWNER OR CONTRACTOR DEBRA B. GREEN & LYNNE HAMBY PHONE Business Home 539-5396

ADDRESS 118 FARMLAND DRIVE, UNION GROVE NC 28689

LOCATION I-77 N, TL NC 901, TR UNION GROVE RD, TR HOLLAND FARM RD, 1ST MH ON (L) PAST

SUBD: BLOCK / SECTION LOT LOT AREA ~10 ACRES SITE CLASS PS DESIGN FLOW 360 L.T.A.R. 0.3 GPD/FT2

Septic Tank 1000 Gallons: STB 620 Date 5-23-95
Pump Tank Gallons: PT Date
Pump Make: Model Serial No.
Nitrification Field: No Fields 1 Square Feet 1200 Linear Feet 400
No Lines 4 Trench Width 36" Max Trench Bottom Depth 18" - 36" Gravel Depth 12"

✓ New System Repair System Type: I II III IV V
System Description: CONVENTIONAL, GRAVITY
Repair System Description: CONV. GRAVITY
Maintenance Agreement Required: Yes ✓ No


House/Mod. Home No. Bedrooms 3
✓ Mobile Home No. Bathrooms 2
Business No. Employees
Other
Slab ✓ Crawl Space Basement w/plumbing Basement wo/plumbing

Water Supply: ✓ Individual Community Public WELL

Comments ① KEEP SYSTEM MINIMUM 5' FROM MH, 100' FROM WELL ② INSTALL LINES AS SHOWN, ON CONTOUR, NO DEEPER THAN 36", 9' MINIMUM APART ON CENTERS

Comments

INITIAL SITE SKETCH

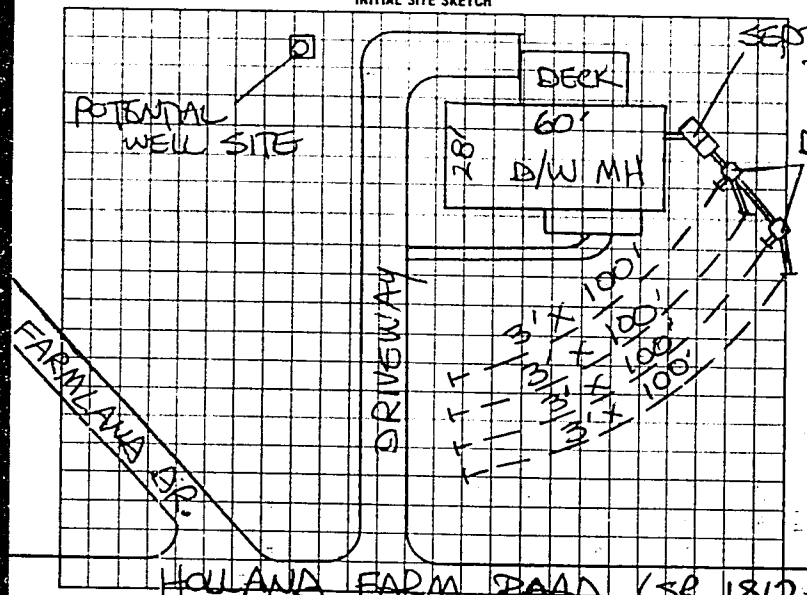

AS BUILT SKETCH

SYSTEM INSTALLED ACCORDING TO INITIAL SITE SKETCH

FARMLAND DRIVE

I understand that this permit can be suspended or revoked if any false information is supplied toward securing the permit/any unauthorized changes are made to the site/any unauthorized changes are made in the installation of the system.

Signed: +Debra B Green

Improvement Permit by: STEVE HEDRICK date 8-25-95

Existing System Inspection by: date

Installed by: SAMMY REAVIS

Certificate of Completion by: STEVE HEDRICK date 9-13-95

Operation Permit by date

HEALTH DEPT COPY: WHITE INSPECTION COPY (FINAL): GREEN OWNER COPY (FINAL): YELLOW INSPECTION COPY (INITIAL): PINK OWNER COPY (INITIAL): GOLD