IREDELL COUNTY HEALTH DEPARTMENT

STATESVILLE 704-878-5305 MOORESVILLE 704-664-5281

IMPROVEMENT PERMIT / CERTIFICATE OF COMPLETION / OPERATION PERMIT / EXISTING SYSTEM INSPECTION

PROPERTY DESCRIPTION NO. 069341 DATE 9-11-97 TAX MAP NO. 4860079476 Watershed: ☐ Yes ☒ No

OWNER OR CONTRACTOR RICHARD PAXTON HIX PHONE: Business Home 876-3125

ADDRESS 406 TATUM ROAD OWN NC 28660

LOCATION I-77 N, TR TOMLIN MILL, TL RASH, TR TATUM, ON LFT 0.8 MILE AT BOX 400, BACK OFF

SUBDIVISION BLOCK / SECTION LOT LOT AREA 57.0 ACRES SITE CLASS. PS DESIGN FLOW 240 L.T.A.R. 0.30 GPD/FT

Septic Tank: 1000 Gallons; STB 1012 Date 11-2-00

Pump Tank: Gallons; PT Date

Pump Make: Model Serial No.

Nitrification Field: No Fields 1 Square Feet 810 Linear Feet 270

No Lines THREE Trench Width 36" Max Trench Bottom Depth 36" Gravel Depth 12"

☒ New System ☐ Repair System Type: I, II, III, IV, V, VI

System Description: CONVENTIONAL GRAVITY

Repair System Description: CONV. GRAVITY

Maintenance Agreement Required: ☐ Yes ☐ No

☐ House/Mod. Home No. Bedrooms 3

☐ Mobile Home No. Bathrooms 2

☐ Business No. Employees

☐ Other

☐ Slab ☐ Crawl Space ☐ Basement w/plumbing ☐ Basement wo/plumbing


Water Supply: ☑ Individual ☐ Community ☐ Public WELL

ROAD


Comments: INSTALL LINES ON CONTOUR.

Comments: ① SEPTIC TANK WITH MARKER INSTALLED USING "POLYLOK" FILTER
② MH ORIENTED AS SHOWN BELOW

INITIAL SITE SKETCH SCALE: 1"=40'

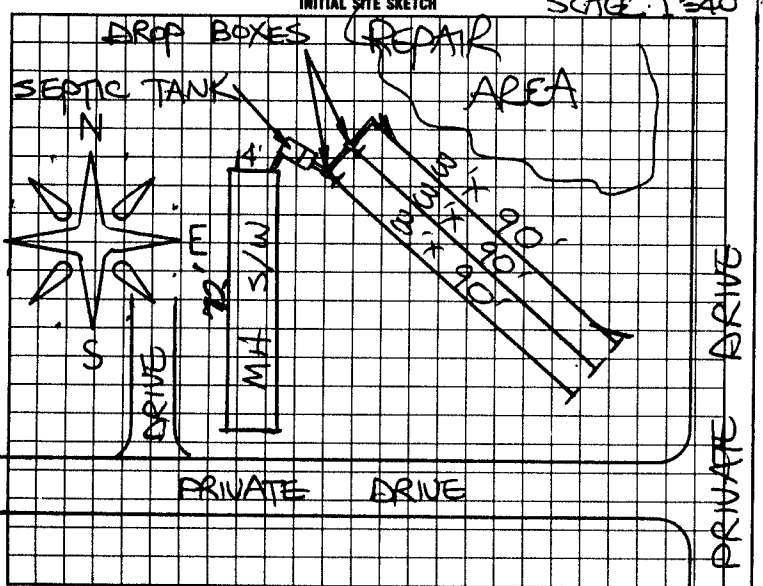

AS BUILT SKETCH

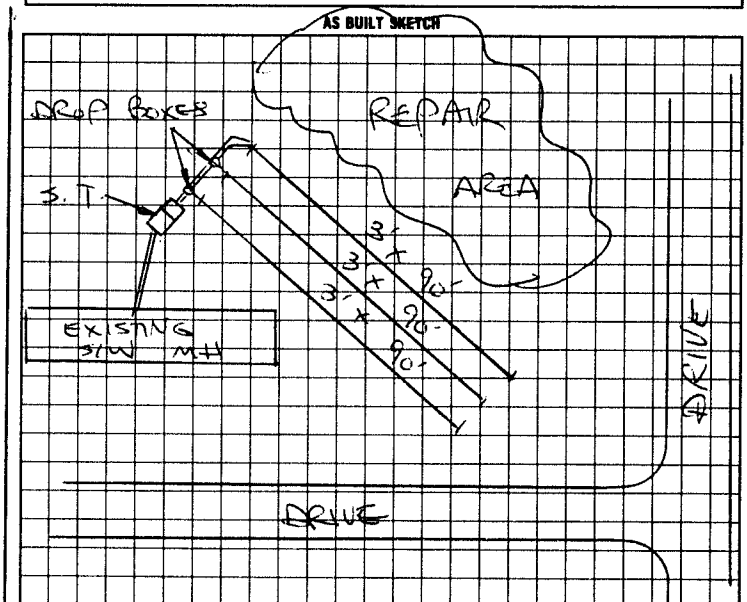

I understand that this permit can be suspended or revoked if any false information is supplied toward securing the permit/any unauthorized changes are made to the site/any unauthorized changes are made in the installation of the system. Improvement Permit is valid for 60 months from date of issuance. AUTHORIZATION TO CONSTRUCT IS VALID FOR 60 MONTHS FROM DATE OF ISSUANCE.

Signed:

Improvement Permit by: STEVE HEDRICK date 9-11-97

AUTH. TO CONST. ~~Existing System Inspection~~ by: STEVE HEDRICK date 9-11-97

Installed by: A-1 BACKHOE

~~Certificate of Completion by:~~ date

Operation Permit by: STEVE HEDRICK date 3-02-01

HEALTH DEPT. COPY: WHITE INSPECTION COPY (FINAL): GREEN OWNER COPY (FINAL): YELLOW INSPECTION COPY (INITIAL): PINK OWNER COPY (INITIAL): GOLD