1:00

THIS PERMIT VOIDS PREVIOUS ISSUED 2-7-2007

IREDELL COUNTY HEALTH DEPARTMENT - *ENVIRONMENTAL HEALTH* ☐ STATESVILLE OFFICE 704-878-5305 ☐ MOORESVILLE OFFICE 704-664-5281

IMPROVEMENT PERMIT / AUTHORIZATION TO CONSTRUCT / OPERATION PERMIT / EXISTING SYSTEM INSPECTION

PERMIT # 170105 PIN # 4860-28-1649 DATE JANUARY 20, 2012

OWNER PABLO & CHERYL ARENAS APPLICANT: SAME PHONE: Home/Cell # 704-876-3664 Business # 704-902-4680

SITE ADDRESS 861 TABOR ROAD, OLIN, NC OWNER / APPLICANT ADDRESS 861 TABOR ROAD, OLIN NC 28660

SITE DIRECTIONS US 21 NORTH, TL TABOR ROAD, TL AT BOX #861, 3295 FEET BACK off ROAD

SUBDIVISION BLOCK / SECTION LOT # LOT AREA 46.842 ACRES DESIGN FLOW 600 L.T.A.R. 0.30 GPD/FT2

Septic Tank 1500 Gallons: STB 528 Date 2-12-12

Pump Tank Gallons: PT Date

Pump Make Model Serial #

No. Nitrification Fields: 1 No. Lines SIX Linear Feet 500'+

Trench Width 36" Max. Trench Bottom Depth 36" Gravel Depth N/A

☑ New System ☐ Repair ☐ Expansion System Type I II (III) IV V VI

System Description: 25% REDUCTION, GRAVITY

Repair System Description: 25% REDUCTION, GRAVITY

Maintenance Agreement Required ☐ YES ☑ NO

☑ GRAVITY ☐ PRESSURE

☑ Residence No. Bedrooms 5

☐ Business No. Persons

☐ Other No. Employees


☐ Slab ☐ Crawl Space

☑ Basement w/plumbing ☐ Basement w/o plumbing

Water Supply: ☑ Private WELL ☐ Public ☐ Community

Comments / Conditions (1) INSTALL 25% REDUCTION SYSTEM ON CONTOUR AS SHOWN & FLAGGED ON SITE. (2) USE ONE FLOW DIVIDER TEE TO ACHIEVE EQUAL DISTRIBUTION INTO TWO SETS OF THREE LINES EACH USING SERIAL DISTRIBUTION.

INITIAL SITE SKETCH

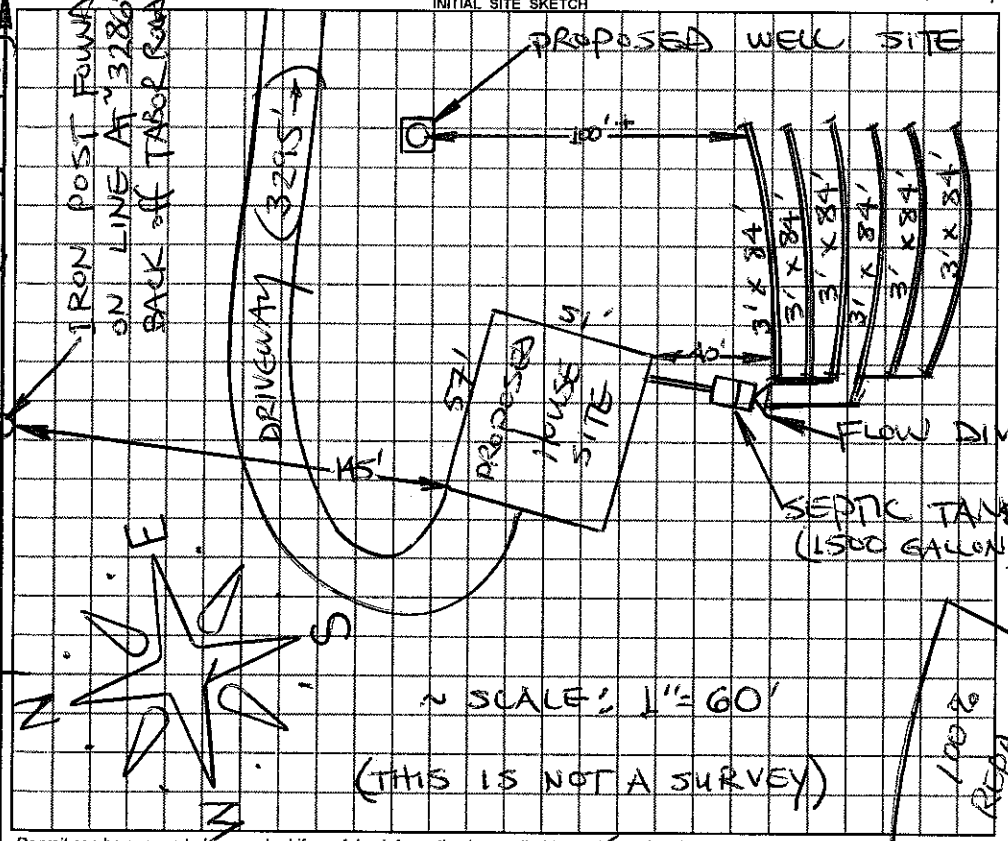

AS BUILT SKETCH

Permit can be suspended or revoked if any false information is supplied toward securing the permit / any unauthorized changes are made to the site / any unauthorized changes are made in the installation of the system.

☐ ***IMPROVEMENT PERMIT*** *with plat valid without expiration.* ☑ ***IMPROVEMENT PERMIT*** *with plat valid without expiration.* ☑ ***AUTHORIZATION TO CONSTRUCT*** valid for period equal to IMPROVEMENT PERMIT--not to exceed 60 mo.

Owner / Applicant Signature: [signature] Date 1-23-12 Installed by: Tommy Fry

IMPROVEMENT PERMIT by: STEVE HEDRICK REHS Date 1-20-2012 OPERATION PERMIT by: [signature] REHS Date 8-20-12

AUTHORIZATION TO CONSTRUCT by: STEVE HEDRICK REHS Date 1-20-2012 Existing System Inspected by: REHS Date

YOU SHOULD CONTACT A LOCATOR SERVICE PRIOR TO ANY EXCAVATION

White Copy – Environmental Health YELLOW COPY (Final) Owner / Applicant PINK COPY (Initial) Owner / Applicant