IREDELL COUNTY HEALTH DEPARTMENT

STATESVILLE 704-878-5305 MOORESVILLE 704-664-5281

IMPROVEMENT PERMIT / AUTHORIZATION TO CONSTRUCT / OPERATION PERMIT / EXISTING SYSTEM INSPECTION

PERMIT# 088210 PIN# 4860 39 8531 (PART) DATE 3-28-00

OWNER OR CONTRACTOR GARY PRIVETTE PHONE: Business _____ Home 838-1452

ADDRESS 101 BIG FOREST DRIVE, STATESVILLE, NC 28677

LOCATION US 21 N, TL TABOR ROAD, TL CANFIELD DRIVE, LOT AT END on RIGHT BEFORE CUL-DE-SAC

SUBDIVISION HEATHSTEAD BLOCK / SECTION _____ LOT 12 LOT AREA 1.12 ACRES SITE CLASS P3 DESIGN FLOW 480 L.T.A.R. 0.30 GPD/FT²

Septic Tank: 1000 Gallons; STB 1012 Date 11 2099
Pump Tank: _____ Gallons; PT _____ Date _____
Pump Make: _____ Model _____ Serial No. _____
Nitrification Field: No Fields 1 Square Feet 59.90 1600 Linear Feet 400
No Lines FIVE Trench Width 36" Max Trench Bottom Depth 30" Gravel Depth SAND 6"

☑ New System ☐ Repair System Type: I, II, (III), IV, V, VI
System Description: 25% REDUCTION GRAVITY
Repair System Description: 25% REDUCTION, PUMP
Maintenance Agreement Required: ☐ Yes ☑ No

☐ House/Mod. Home ☑ Mobile Home ☐ Business ☐ Other _____
No. Bedrooms 4 No. Bathrooms 2½ No. Employees ____


Water Supply: ☐ Individual ☑ Public ☐ Community

☐ Slab ☑ Crawl Space ☐ Basement w/plumbing ☐ Basement wo/plumbing


Comments/Conditions: ① CONSTRUCT SUBSURFACE INTERCEPT DRAINAGE DITCH AT LOCATION SHOWN BEGINNING 12 INCHES DEEP OUT TO DAYLIGHT ② INSTALL 25% REDUCTION SYSTEM USING 67 CHAMBERS OR 40 HDS SECTIONS

Comments/Conditions: 4-6: Lines + Tank installed As shown

INITIAL SITE SKETCH SCALE: 1"=50'

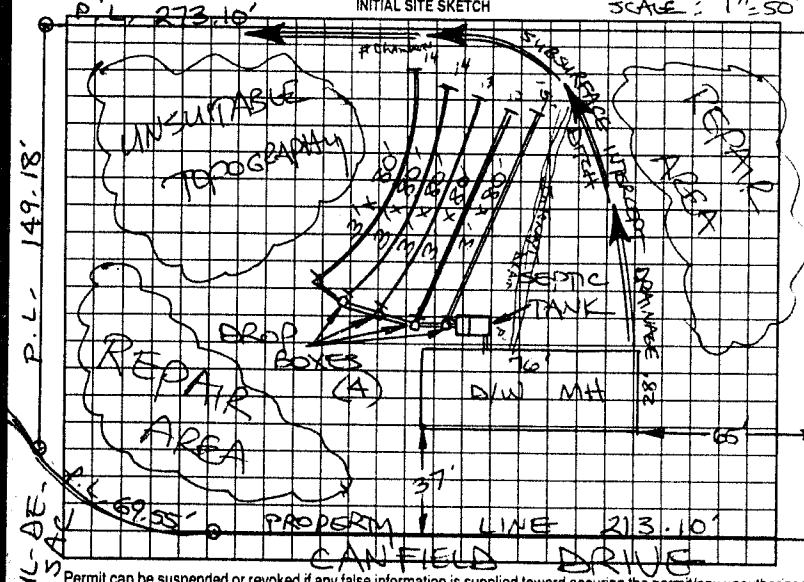

AS BUILT SKETCH

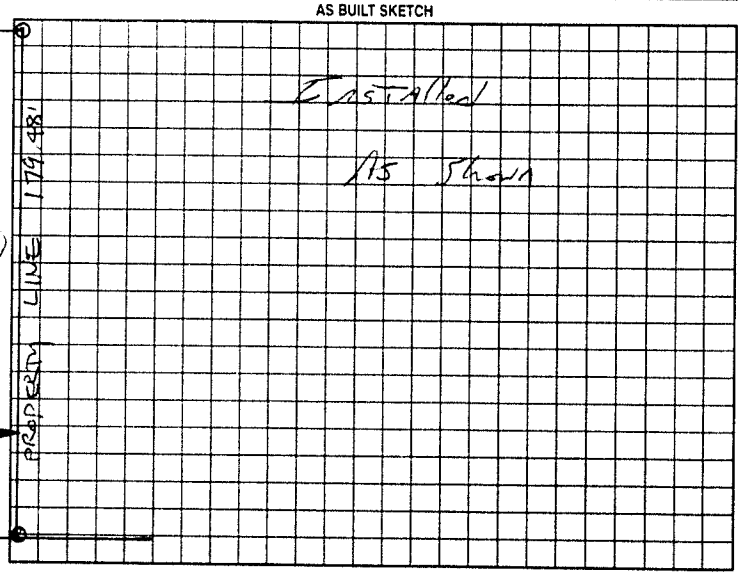

Permit can be suspended or revoked if any false information is supplied toward securing the permit/any unauthorized changes are made to the site/any unauthorized changes are made in the installation of the system. Improvement Permit with plat valid without expiration. Improvement Permit with site plan valid for sixty months. Authorization to Construct is valid for a period equal to that of Improvement Permit – not to exceed sixty months.

Signed: _____ date 3-27-00 Installed by: M Buckhoe

Improvement Permit by: STEVE HEDRICK date 3-28-00 Operation Permit by: _____ date April 7 2000

Authorization to Construct by: STEVE HEDRICK date 3-28-00 Existing System Inspection by: _____ date _____

HEALTH DEPT. COPY. WHITE OWNER COPY (FINAL) YELLOW OWNER COPY (INITIAL) PINK