IREDELL COUNTY HEALTH DEPARTMENT

STATESVILLE 704-878-5305 MOORESVILLE 704-664-5281

IMPROVEMENT PERMIT / AUTHORIZATION TO CONSTRUCT / OPERATION PERMIT / EXISTING SYSTEM INSPECTION

PERMIT# 083395 PIN# 4860 39 8531 DATE 8-20-99

OWNER OR CONTRACTOR WHITE WOLF PROPERTIES PHONE: Business 532-6625 Home

ADDRESS 6551 MONROE ROAD, CHARLOTTE NC 28212

LOCATION US 21 N, TL TABOR RD, TL CANFIELD DRIVE, LOT AT END OF CUL-DE-SAC

SUBDIVISION HEATHSTEAD BLOCK / SECTION LOT 14 LOT AREA 1.16 ACRES SITE CLASS PS DESIGN FLOW 360 L.T.A.R. 0.30 gpd/ftr

Septic Tank: 1000 Gallons; STB 7786 Date 6-30-99
Pump Tank: Gallons; PT Date
Pump Make: Model Serial No.
Nitrification Field: No Fields 1 Square Feet 1200 Linear Feet 400
No Lines FIVE Trench Width 36" Max Trench Bottom Depth 36" Gravel Depth 12"

☑ New System ☐ Repair System Type: I II III IV V VI
System Description: CONVENTIONAL GRAVITY
Repair System Description: 25% REDUCTION GRAVITY
Maintenance Agreement Required: ☐ Yes ☑ No
☐ Slab ☑ Crawl Space ☐ Basement w/plumbing ☐ Basement wo/plumbing


☐ House/Mod. Home No. Bedrooms 3
☑ Mobile Home No. Bathrooms 2
☐ Business No. Employees
☐ Other

Water Supply: ☐ Individual ☑ Public ☐ Community


Comments/Conditions: CUL-DE-SAC

Comments/Conditions: SEPTIC TANK WITH LOCATOR INSTALLED USING "POLYLOK" FILTER

SCALE: 1"=50' INITIAL SITE SKETCH

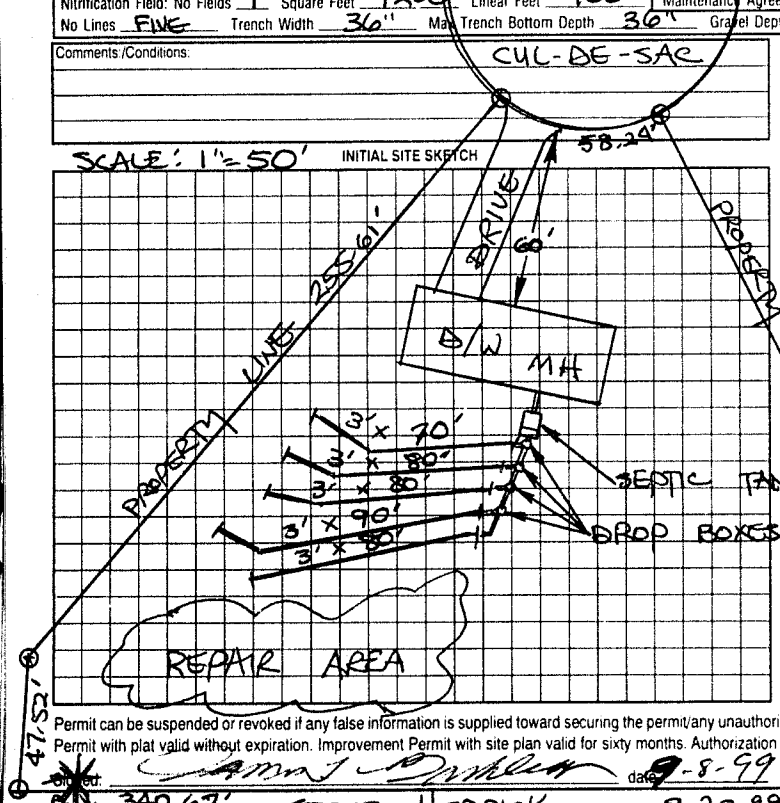

AS BUILT SKETCH

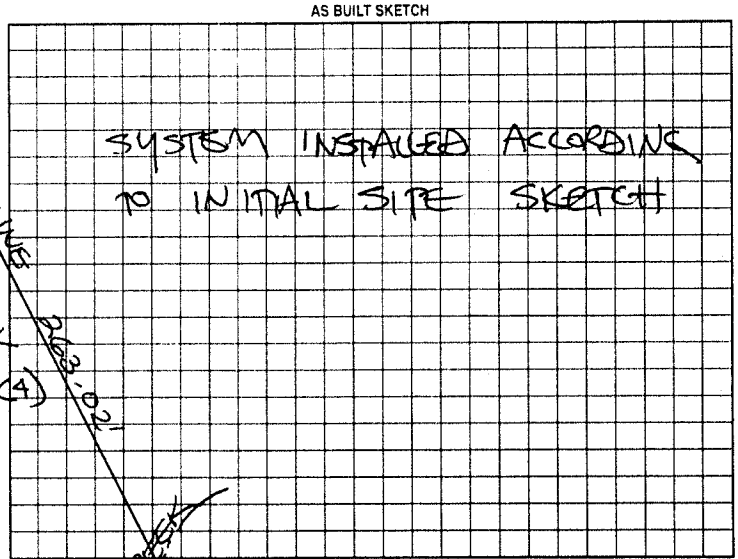

Permit can be suspended or revoked if any false information is supplied toward securing the permit/any unauthorized changes are made to the site/any unauthorized changes are made in the installation of the system. Improvement Permit with plat valid without expiration. Improvement Permit with site plan valid for sixty months. Authorization to Construct is valid for a period equal to that of Improvement Permit – not to exceed sixty months.

Signed: date 9-8-99 Installed by: G & M ENTERPRISES

Improvement Permit by: STEVE HEDRICK date 8-20-99 Operation Permit by: STEVE HEDRICK date 9-16-99

Authorization to Construct by: STEVE HEDRICK date 8-20-99 Existing System Inspection by: date

HEALTH DEPT COPY WHITE OWNER COPY (FINAL) YELLOW / OWNER COPY (INITIAL) PINK