IREDELL COUNTY HEALTH DEPARTMENT

STATESVILLE 704-878-5305 MOORESVILLE 704-664-5281

IMPROVEMENT PERMIT / AUTHORIZATION TO CONSTRUCT / OPERATION PERMIT / EXISTING SYSTEM INSPECTION

PERMIT# 084054 PIN# 4860 39 8531 (PART) DATE 10-13-99

OWNER OR CONTRACTOR A-1 MOBILE HOMES PHONE: Business 873-1014 Home

ADDRESS 590 MOCKSVILLE HIGHWAY, STATESVILLE, NC 28677

LOCATION US 21 N, TL TABOR ROAD, TL CANFIELD ROAD, LOT #11 AT BACK OF SUBDIVISION ON RIGHT

SUBDIVISION HEATHSTEAD BLOCK / SECTION LOT 11 LOT AREA 0.54 ACRE SITE CLASS PS DESIGN FLOW 300 L.T.A.R. 0.35 GPD/FT²

Septic Tank: 1000 Gallons; STB 620 Date 8-21-99
Pump Tank: Gallons; PT Date
Pump Make: Model Serial No.
Nitrification Field: No Fields 1 Square Feet EQ. TO 1035 Linear Feet 345
No Lines FOUR Trench Width 36" Max Trench Bottom Depth 36" ~~Gravel~~ Depth 6" SAND

✓ New System ☐ Repair System Type: I, II, III, IV, V, VI
System Description: 25% REDUCTION GRAV.
Repair System Description: 25% REDUCTION PUMP
Maintenance Agreement Required: ☐ Yes ✓ No

☐ House/Mod. Home ✓ Mobile Home ☐ Business ☐ Other
No. Bedrooms 3 No. Bathrooms 2 No. Employees


☐ Slab ✓ Crawl Space ☐ Basement w/plumbing ☐ Basement wo/plumbing

Water Supply: ☐ Individual ☐ Public ☐ Community

Comments/Conditions: INSTALL 25% REDUCTION GRAVITY-FED SYSTEM USING 43 CHAMBERS OR 35 HDS SECTIONS ON CONTOUR AS FLAGGED

Comments/Conditions: SEPTIC TANK WITH RISERS AND MARKER INSTALLED USING "ZABEL" FILTER

INITIAL SITE SKETCH SCALE: 1"=40'

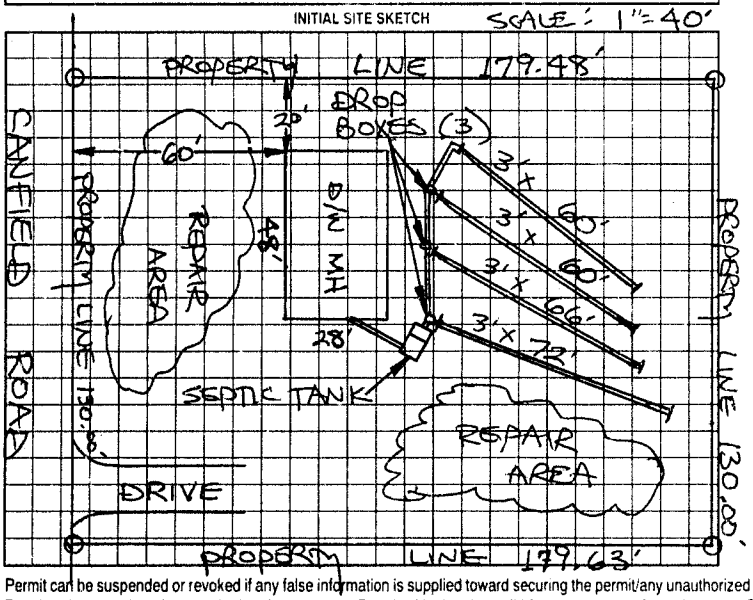

AS BUILT SKETCH

SYSTEM INSTALLED ACCORDING TO INITIAL SITE SKETCH

Permit can be suspended or revoked if any false information is supplied toward securing the permit/any unauthorized changes are made to the site/any unauthorized changes are made in the installation of the system. Improvement Permit with plat valid without expiration. Improvement Permit with site plan valid for sixty months. Authorization to Construct is valid for a period equal to that of Improvement Permit – not to exceed sixty months.

Signed: [signature] date 10-14-99 Installed by: SAMMY REAVLS

Improvement Permit by: STEVE HEDRICK date 10-13-99 Operation Permit by: STEVE HEDRICK date 11-5-99

Authorization to Construct by: STEVE HEDRICK date 10-13-99 Existing System Inspection by: date

HEALTH DEPT COPY WHITE OWNER COPY (FINAL) YELLOW OWNER COPY (INITIAL) PINK