IREDELL COUNTY HEALTH DEPARTMENT

STATESVILLE 704-878-5305 MOORESVILLE 704-664-5281

IMPROVEMENT PERMIT / AUTHORIZATION TO CONSTRUCT / OPERATION PERMIT / EXISTING SYSTEM INSPECTION

PERMIT# 084158 PIN# 4860 39 8531 (PART) DATE 10-18-99

OWNER OR CONTRACTOR JERRY BRADY PHONE: Business 662-9642 Home (704) 598-3568

ADDRESS 3441 PONDRIDGE CT., CHARLOTTE NC 28269

LOCATION US 21 N TL TABOR RD. TL CANFIELD RD. AT BACK ON RIGHT AT CURVE

SUBDIVISION HEATHSTEAD BLOCK / SECTION ____ LOT 10 LOT AREA 0.74 ACRE SITE CLASS PS DESIGN FLOW 360 L.T.A.R. 0.30 GPD/FT²

Septic Tank: 1000 Gallons; STB 786 Date 10-1-99
Pump Tank: ____ Gallons; PT ____ Date ____
Pump Make: ____ Model ____ Serial No. ____
Nitrification Field: No Fields 1 Square Feet ~~ERTO~~ 1200 Linear Feet 300
No Lines FIVE Trench Width 36" Max Trench Bottom Depth 36"

☑ New System ☐ Repair System Type: I. II. (III) IV. V.
System Description: 25% REDUCTION GRAVITY
Repair System Description: 25% REDUCTION PUMP
Maintenance Agreement Required: ☐ Yes ☑ No
~~☐ Crawl~~ Depth 6' SAND ☐ Slab ☑ Crawl Space ☐ Basement w/plumbing ☐ Basement wo/plumbing


☐ House/Mod. Home No. Bedrooms 3
☐ Mobile Home No. Bathrooms 2
☐ Business No. Employees ____
☐ Other ____

Water Supply: ☐ Individual ☑ Public ☐ Community

Comments/Conditions: INSTALL 25% REDUCTION SYSTEM USING FIFTY (50) CHAMBERS OR THIRTY (30) HDS SECTIONS

Comments/Conditions: SEPTIC TANK WITH ~~MARKER~~ INSTALLED USING "POLYLOK" FILTER ② HDS SYSTEM INSTALLED USING 30 SECTIONS ③ SYSTEM INSTALLED DURING PERIOD OF WET SOIL CONDITIONS

INITIAL SITE SKETCH SCALE: 1" = 50'

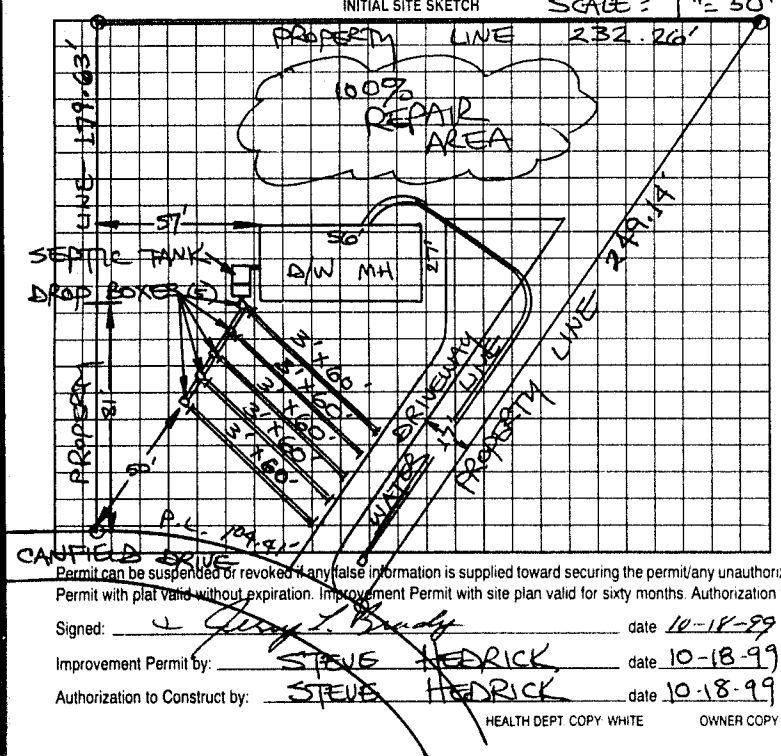

AS BUILT SKETCH

SYSTEM INSTALLED ACCORDING TO INITIAL SITE SKETCH (DISTRIBUTION BOXES W/ SPEED LEVELERS SUBSTITUTED FOR DROP BOXES)

Permit can be suspended or revoked if any false information is supplied toward securing the permit/any unauthorized changes are made to the site/any unauthorized changes are made in the installation of the system. Improvement Permit with plat valid without expiration. Improvement Permit with site plan valid for sixty months. Authorization to Construct is valid for a period equal to that of Improvement Permit – not to exceed sixty months.

Signed: Jerry T. Brady date 10-18-99

Improvement Permit by: STEVE HEDRICK date 10-18-99

Authorization to Construct by: STEVE HEDRICK date 10-18-99

Installed by: LARRY REED

Operation Permit by: STEVE HEDRICK date 2-22-00

Existing System Inspection by: ____ date ____

HEALTH DEPT COPY WHITE OWNER COPY (FINAL) YELLOW OWNER COPY (INITIAL) PINK