2. T. Frye

IREDELL COUNTY HEALTH DEPARTMENT

STATESVILLE 704-878-5305 MOORESVILLE 704-664-5281

IMPROVEMENT PERMIT / AUTHORIZATION TO CONSTRUCT / OPERATION PERMIT / EXISTING SYSTEM INSPECTION

PERMIT# 90078 PIN# 4860398531 PT DATE 7/12/00

OWNER OR CONTRACTOR WHITE WOLF PROP. PHONE: Business 532-6625 Home

ADDRESS 5551 MONROE RD CHARLOTTE NC 28212

LOCATION HWY 21N - TL TABOR RD - TL CANFIELD - lot 17 ON LT

SUBDIVISION HEATHSTED BLOCK / SECTION LOT 17 LOT AREA 1.341C SITE CLASS PS DESIGN FLOW 360GPD L.T.A.R. .3610/AC

Septic Tank: 1000 Gallons; STB 1012 Date 6/18/00
Pump Tank: Gallons; PT Date
Pump Make: Model Serial No.
Nitrification Field: No Fields 1 Square Feet 1700 Linear Feet 400
No Lines 3@133' Trench Width 36" Max Trench Bottom Depth 36"


New System ☐ Repair System Type: I II III IV V VI
System Description: GRAVITY CONVENTIONAL
Repair System Description: PUMP SAME
Maintenance Agreement Required: ☐ Yes ☐ No
Gravel Depth 12" ☐ Slab ☐ Crawl Space ☐ Basement w/plumbing ☐ Basement wo/plumbing

☐ House/Mod. Home No. Bedrooms 3
☐ Mobile Home No. Bathrooms 3
☐ Business No. Employees
☐ Other

Water Supply: ☐ Individual ☑ Public ☐ Community


Comments/Conditions:

INITIAL SITE SKETCH

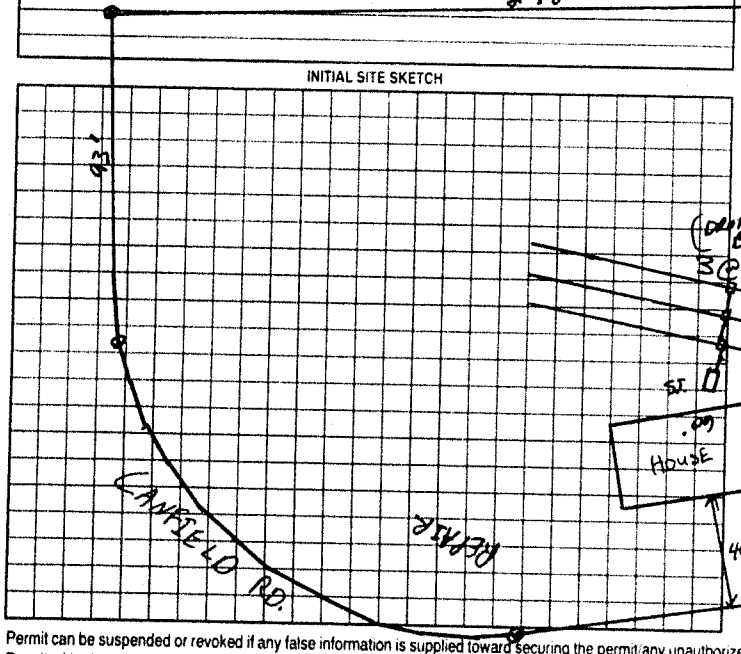

Comments/Conditions

AS BUILT SKETCH

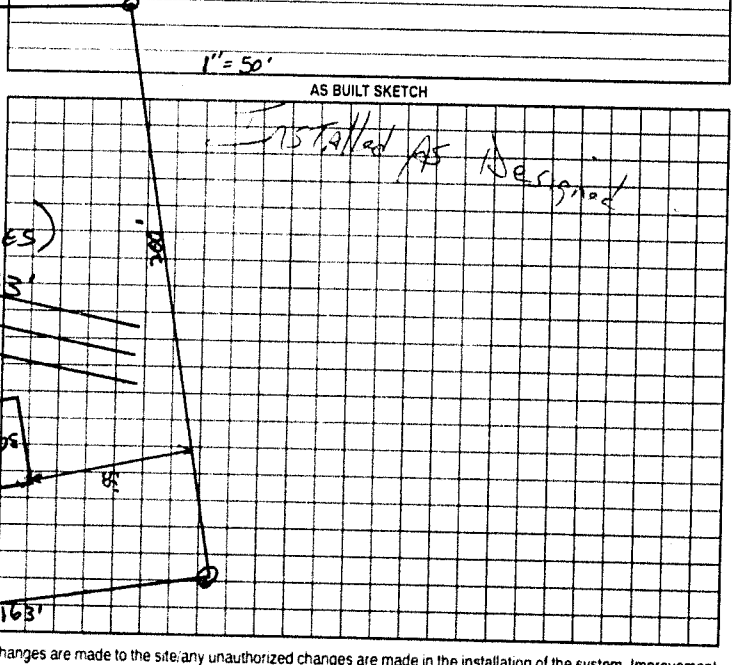

Permit can be suspended or revoked if any false information is supplied toward securing the permit/any unauthorized changes are made to the site/any unauthorized changes are made in the installation of the system. Improvement Permit with plat valid without expiration. Improvement Permit with site plan valid for sixty months. Authorization to Construct is valid for a period equal to that of Improvement Permit – not to exceed sixty months.

Signed: [signature] date 7-13-00 Installed by: T Frye

Improvement Permit by: C. Bly RS date 7/12/00 Operation Permit by: [signature] date 1-11-2001

Authorization to Construct by: C. Bly RS date 7/12/00 Existing System Inspection by: date

HEALTH DEPT COPY WHITE OWNER COPY (FINAL) YELLOW OWNER COPY (INITIAL) PINK