IREDELL COUNTY HEALTH DEPARTMENT

STATESVILLE 704-878-5305 MOORESVILLE 704-664-5281

IMPROVEMENT PERMIT / AUTHORIZATION TO CONSTRUCT / OPERATION PERMIT / EXISTING SYSTEM INSPECTION

PERMIT# 090077 PIN# 4860 39 8531 (PT) DATE 2-8-01

OWNER OR CONTRACTOR WHITE WOLF PROP. PHONE: Business (704) 532-6626 Home

ADDRESS 5551 MONROE ROAD, CHARLOTTE NC 28212

LOCATION US 21 N, TL TABOR RD, TL CANFIELD DR, LOT ON LEFT AT PRESCOTT DRIVE

SUBDIVISION HEATHSTEAD BLOCK / SECTION LOT 18 LOT AREA 1.93 ACRES SITE CLASS PS DESIGN FLOW 360 L.T.A.R. 0.30 GPD/FT²

Septic Tank: 1000 Gallons: STB 312 Date 9-18-00
Pump Tank: Gallons: PT Date
Pump Make: Model Serial No.
Nitrification Field: No Fields 1 Square Feet EQ. TO 1200 Linear Feet 300
No. Lines FOUR Trench Width 36" Max Trench Bottom Depth 36" Gravel Depth N/A

☑ New System ☐ Repair System Type: I, II, (III), IV, V, VI
System Description: 25% REDUCTION, GRAVITY
Repair System Description: 50% REDUCTION, PUMP
Maintenance Agreement Required: ☐ Yes ☑ No

☐ House/Mod. Home ☑ Mobile Home ☐ Business ☐ Other
No. Bedrooms 3 No. Bathrooms 2 No. Employees


☐ Slab ☑ Crawl Space ☐ Basement w/plumbing ☐ Basement wo/plumbing

Water Supply: ☐ Individual ☑ Public ☐ Community

Comments/Conditions: ① INSTALL 25% REDUCTION SYSTEM USING FIFTY (50) CHAMBERS OR THEM (30) HAS SECTIONS
② NO CUTTING OR FILLING ALLOWED OVER DRAINFIELD

Comments/Conditions: – Septic Tank marker Installed
– poly lok filter Installed
– 50 Infiltrator Chambers Installed

INITIAL SITE SKETCH

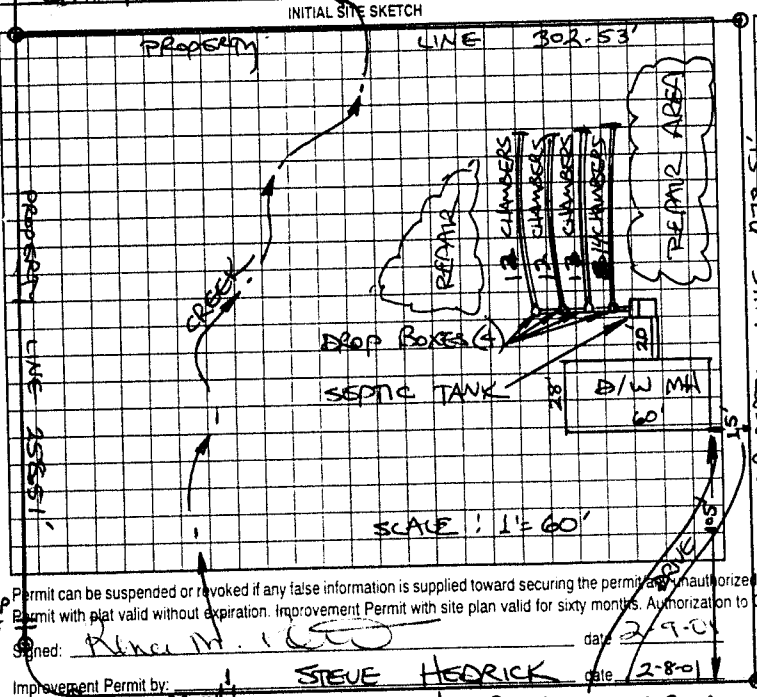

AS BUILT SKETCH

Installed as Shown

Permit can be suspended or revoked if any false information is supplied toward securing the permit and unauthorized changes are made to the site/any unauthorized changes are made in the installation of the system. Improvement Permit with plat valid without expiration. Improvement Permit with site plan valid for sixty months. Authorization to Construct is valid for a period equal to that of Improvement Permit – not to exceed sixty months.

Signed: Richard M. Lee date 2-9-01 Installed by: Craig Thompson

Improvement Permit by: STEVE HEDRICK date 2-8-01 Operation Permit by: William O. Johnson RS date 2/21/01

Authorization to Construct by: STEVE HEDRICK date 2-8-01 Existing System Inspection by: date

HEALTH DEPT COPY WHITE OWNER COPY (FINAL) YELLOW OWNER COPY (INITIAL) PINK