IREDELL COUNTY HEALTH DEPARTMENT

STATESVILLE 704-878-5305 MOORESVILLE 704-664-5281

IMPROVEMENT PERMIT / AUTHORIZATION TO CONSTRUCT / OPERATION PERMIT / EXISTING SYSTEM INSPECTION

PERMIT# 094086 PIN# 4860 39 6169 DATE 2-27-01

OWNER OR CONTRACTOR CORINNE COX PHONE: Business Home (704) 528-0848

ADDRESS c/o 1036 CHARLOTTE HWY, TROUTMAN, NC 28166

LOCATION US 21 N, TL TABOR RD, TL CANFIELD DR, TL PRESCOTT DR, AT END ON LEFT

SUBDIVISION HEATHSTEAD BLOCK / SECTION ____ LOT 20 LOT AREA 1.13 ACRE SITE CLASS PS DESIGN FLOW 360 L.T.A.R. 0.30 GAD/FT²

Septic Tank: 1000 Gallons; STB 794 Date 4-25-00
Pump Tank: ____ Gallons; PT ____ Date ____
Pump Make: ____ Model ____ Serial No. ____
Nitrification Field: No Fields 1 Square Feet 1200 Linear Feet 400
No Lines FOUR Trench Width 36" Max Trench Bottom Depth 32" Gravel Depth 12"

☑ New System ☐ Repair System Type: I II III IV V VI
System Description: CONVENTIONAL GRAVITY
Repair System Description: CONV. GRAVITY
Maintenance Agreement Required: ☐ Yes ☑ No


☐ House/Mod. Home ☑ Mobile Home ☐ Business ☐ Other
No. Bedrooms 3 No. Bathrooms 2 No. Employees ____
☐ Slab ☑ Crawl Space ☐ Basement w/plumbing ☐ Basement wo/plumbing

Water Supply: ☐ Individual ☑ Public ☐ Community


Comments/Conditions: INSTALL LINES ON CONTOUR AS FLAGGED ON SITE

Comments/Conditions: SEPTIC TANK WITH MARKER
INSTALL USING "POLYLOK" FILTER

SCALE 1" = 50' INITIAL SITE SKETCH

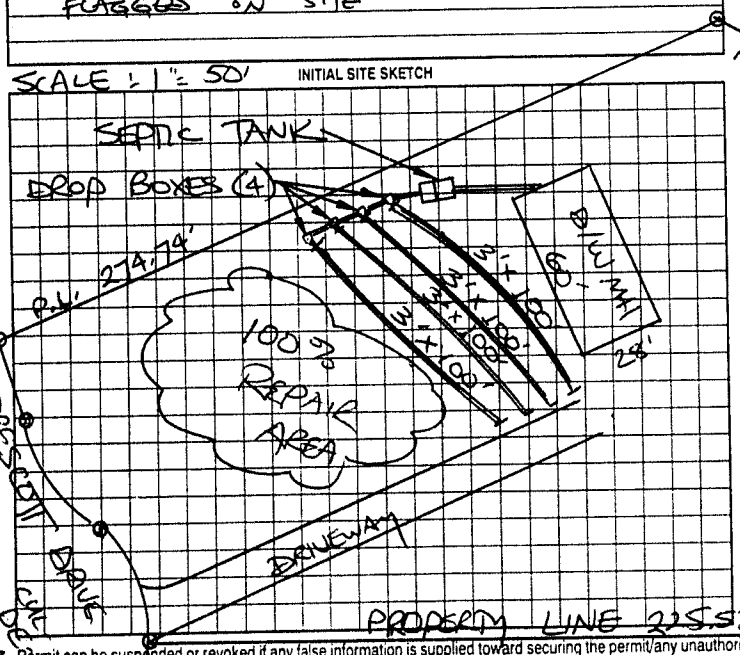

AS BUILT SKETCH

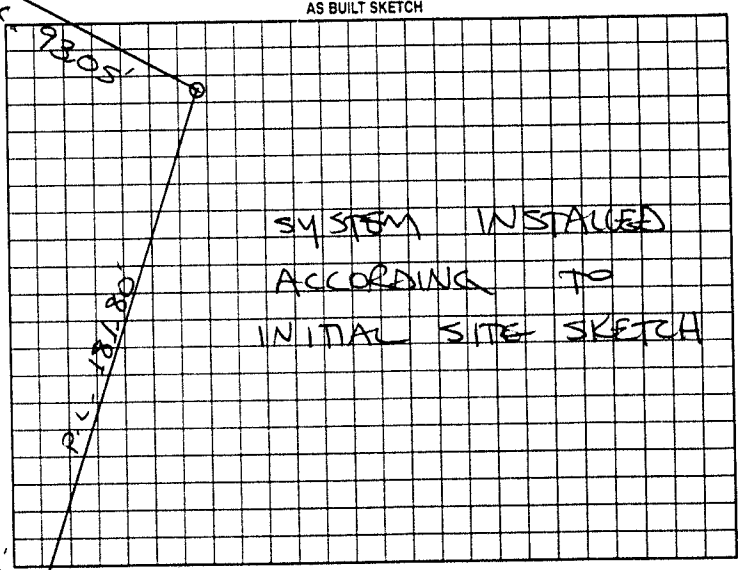

Permit can be suspended or revoked if any false information is supplied toward securing the permit/any unauthorized changes are made to the site/any unauthorized changes are made in the installation of the system. Improvement Permit with plat valid without expiration. Improvement Permit with site plan valid for sixty months. Authorization to Construct is valid for a period equal to that of Improvement Permit – not to exceed sixty months.

Signed: + Bruce R Burris date 02/27/01 Installed by: ANDY DANIELS

Improvement Permit by: STEVE HEDRICK date 2-27-01 Operation Permit by: STEVE HEDRICK date 3-08-01

Authorization to Construct by: STEVE HEDRICK date 2-27-01 Existing System Inspection by: ____ date ____

HEALTH DEPT COPY WHITE OWNER COPY (FINAL) YELLOW OWNER COPY (INITIAL) PINK