IREDELL COUNTY HEALTH DEPARTMENT

STATESVILLE 704-878-5305 MOORESVILLE 704-664-5281

IMPROVEMENT PERMIT / AUTHORIZATION TO CONSTRUCT / OPERATION PERMIT / EXISTING SYSTEM INSPECTION

PERMIT# 094871 PIN# 4860 39 8531 (PART) DATE 4-24-01

OWNER OR CONTRACTOR WHITEWOLF PROPERTIES PHONE: Business (704) 532-6625 Home

ADDRESS 5551 MONROE ROAD, CHARLOTTE, NC 28212

LOCATION US 21 NORTH, TL TABOR ROAD, TL CANFIELD DRIVE, TL PRESCOTT ROAD, 1ST LOT ON LEFT

SUBDIVISION HEATHSTEAD BLOCK / SECTION LOT 23 LOT AREA 0.80 ACRE SITE CLASS PS DESIGN FLOW 360 L.T.A.R. 0.25 GPD/FT²

Septic Tank: 1000 Gallons; STB 354 Date 2-7-01

Pump Tank: Gallons; PT Date

Pump Make: Model Serial No.

Nitrification Field: No Fields 1 Square Feet REQ. 1440 Linear Feet 240

No Lines EIGHT Trench Width 24" Max Trench Bottom Depth 36" Gravel Depth SAND 6"

☑ New System ☐ Repair System Type: I, II, (III), IV, V, VI

System Description: 50% REDUCTION GRAVITY

Repair System Description: 50% REDUCTION, PUMP

Maintenance Agreement Required: ☐ Yes ☑ No

☐ House/Mod. Home ☑ Mobile Home ☐ Business ☐ Other

No. Bedrooms 3 No. Bathrooms 2 No. Employees


☐ Slab ☑ Crawl Space ☐ Basement w/plumbing ☐ Basement wo/plumbing

Water Supply: ☐ Individual ☑ Public ☐ Community

Comments/Conditions: ① INSTALL 50% REDUCTION SYSTEM USING 56 RPBPS PAVERS IN 8 EQUAL LENGTH LINES ② USE THREE FLOW DIVIDER TEES TO ACHIEVE EQUAL DISTRIBUTION INTO 4 DIST. BOXES FEEDING 2 LINES EACH ③ INSTALL SUBSURFACE INTERCEPT DRAINAGE DITCH

Comments/Conditions: SEPTIC TANK WITH MARKER INSTALLED USING "POLY LOK" FILTER

SITE SKETCH BEGINNING 48" DEEP.

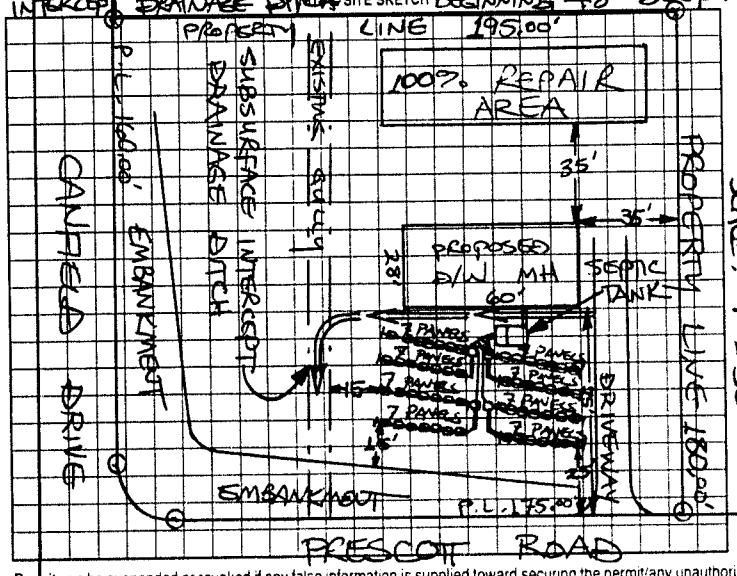

AS BUILT SKETCH

SYSTEM INSTALLED ACCORDING TO INITIAL SITE SKETCH

Permit can be suspended or revoked if any false information is supplied toward securing the permit/any unauthorized changes are made to the site/any unauthorized changes are made in the installation of the system. Improvement Permit with plat valid without expiration. Improvement Permit with site plan valid for sixty months. Authorization to Construct is valid for a period equal to that of Improvement Permit -- not to exceed sixty months.

Signed: date 4-30-01 Installed by: G & M ENTERPRISES

Improvement Permit by: STEVE HEDRICK date 4-24-01 Operation Permit by: STEVE HEDRICK date 5-2-01

Authorization to Construct by: STEVE HEDRICK date 4-24-01 Existing System Inspection by: date

HEALTH DEPT COPY WHITE OWNER COPY (FINAL) YELLOW OWNER COPY (INITIAL) PINK