IREDELL COUNTY HEALTH DEPARTMENT

STATESVILLE 704-878-5305 MOORESVILLE 704-664-5281

IMPROVEMENT PERMIT / AUTHORIZATION TO CONSTRUCT / OPERATION PERMIT / EXISTING SYSTEM INSPECTION

PERMIT# 088404 PIN# 4860-39-8531 (PT) DATE 4-14-00

OWNER OR CONTRACTOR PIEDMONT HOUSING PHONE: Business 872-0170 Home

ADDRESS 1270 NORTHSIDE DR, STATESVILLE, NC 28677

LOCATION US 21 N, TL TABOR RD, TL CANFIELD RD, TL BRANSON DRIVE, AT END ON RIGHT

SUBDIVISION HEATHSTEAD BLOCK / SECTION LOT 27 LOT AREA 0.76 ACRES SITE CLASS PS DESIGN FLOW 360 L.T.A.R. 0.30 GPD/FT²

Septic Tank: 1000 Gallons; STB 1012 Date 3-14-00
Pump Tank: Gallons; PT Date
Pump Make: Model Serial No.
Nitrification Field: No Fields 1 Square Feet 1200 Linear Feet 400
No Lines FIVE Trench Width 36" Max Trench Bottom Depth 36" Gravel Depth 12"

☑ New System ☐ Repair System Type: I (II) III IV V VI
System Description: CONVENTIONAL GRAVITY
Repair System Description: CONV, GRAVITY
Maintenance Agreement Required: ☐ Yes ☑ No
☐ Slab ☑ Crawl Space ☐ Basement w/plumbing ☐ Basement wo/plumbing


☐ House/Mod. Home ☑ Mobile Home ☐ Business ☐ Other
No. Bedrooms 3 No. Bathrooms 2 No. Employees

Water Supply: ☐ Individual ☑ Public ☐ Community


Comments:/Conditions:

Comments:/Conditions: SEPTIC TANK W/ RISERS INSTALLED USING "POLY LOK" FILTER

INITIAL SITE SKETCH SCALE: 1"=50'

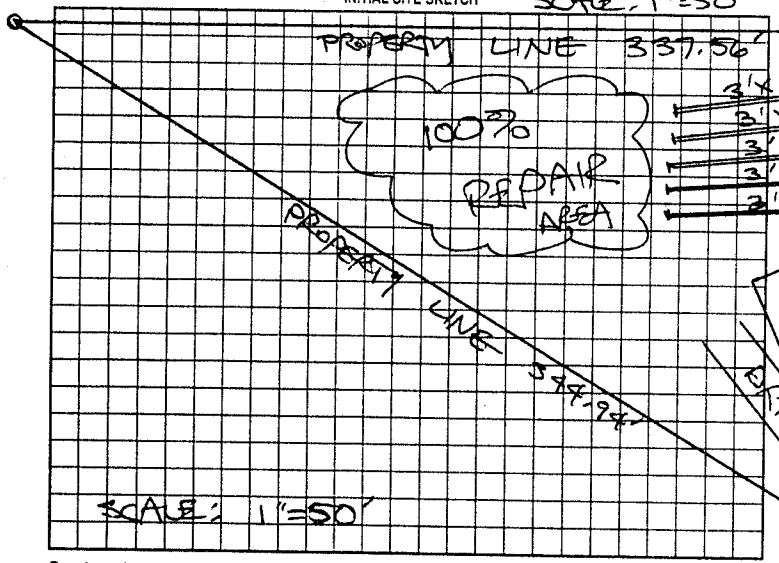

AS BUILT SKETCH

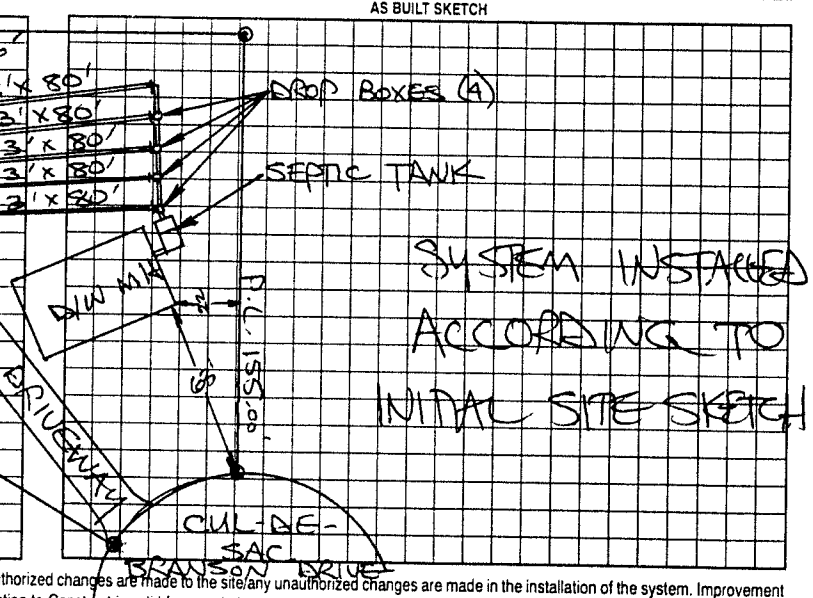

Permit can be suspended or revoked if any false information is supplied toward securing the permit/any unauthorized changes are made to the site/any unauthorized changes are made in the installation of the system. Improvement Permit with plat valid without expiration. Improvement Permit with site plan valid for sixty months. Authorization to Construct is valid for a period equal to that of Improvement Permit – not to exceed sixty months.

Signed: Ken Walters date 4-14-00 Installed by: A-1 BACKHOE

Improvement Permit by: STEVE HEDRICK date 4-14-00 Operation Permit by: STEVE HEDRICK date 5-2-00

Authorization to Construct by: STEVE HEDRICK date 4-14-00 Existing System Inspection by: date

HEALTH DEPT. COPY: WHITE OWNER COPY (FINAL): YELLOW OWNER COPY (INITIAL): PINK