IREDELL COUNTY HEALTH DEPARTMENT

STATESVILLE 704-878-5305 MOORESVILLE 704-664-5281

IMPROVEMENT PERMIT / AUTHORIZATION TO CONSTRUCT / OPERATION PERMIT / EXISTING SYSTEM INSPECTION

PERMIT# 094874 PIN# 4860 39 8531 DATE 4-25-01

OWNER OR CONTRACTOR WHITEWOLF PROPERTIES PHONE: Business (704) 532-6625 Home

ADDRESS 5551 MONROE ROAD, CHARLOTTE NC 28212

LOCATION U.S 21 NORTH, TL TABOR RD, TL CANFIELD DR TL BAANSON DR, 3RD LOT ON RIGHT

SUBDIVISION HEATHSTEAD BLOCK / SECTION LOT 26 LOT AREA 0.50 ACRE SITE CLASS PS DESIGN FLOW 360 L.T.A.R. 0.30 GPD/FT2

Septic Tank: 1000 Gallons: STB 825 Date 8-31-01
Pump Tank: Gallons: PT Date
Pump Make: Model Serial No.
Nitrification Field: No Fields 1 Square Feet EQ.P 1200 Linear Feet 300+
No Lines FOUR Trench Width 36" Max Trench Bottom Depth 36" Gravel Depth N/A

☑ New System ☐ Repair System Type: I. II (III) IV. V. VI
System Description: 25% REDUCTION GRAVITY
Repair System Description: 50% REDUCTION, PUMP
Maintenance Agreement Required: ☐ Yes ☑ No
☐ Slab ☑ Crawl Space ☐ Basement w/plumbing ☐ Basement wo/plumbing


☐ House/Mod. Home ☑ Mobile Home ☐ Business ☐ Other
No. Bedrooms 3 No. Bathrooms 2 No. Employees

Water Supply: ☐ Individual ☑ Public ☐ Community


Comments/Conditions: INSTALL 25% REDUCTION SYSTEM USING 50 CHAMBERS OR 30 HAS' SECTIONS

Comments/Conditions ① SYSTEM ALTERED WITHOUT PRIOR HEALTH DEPARTMENT APPROVAL AS SHOWN ② SEPTIC TANK WITH MARKER INSTALLED USING "POLYLOK" FILTER

INITIAL SITE SKETCH SCALE: 1"=40'

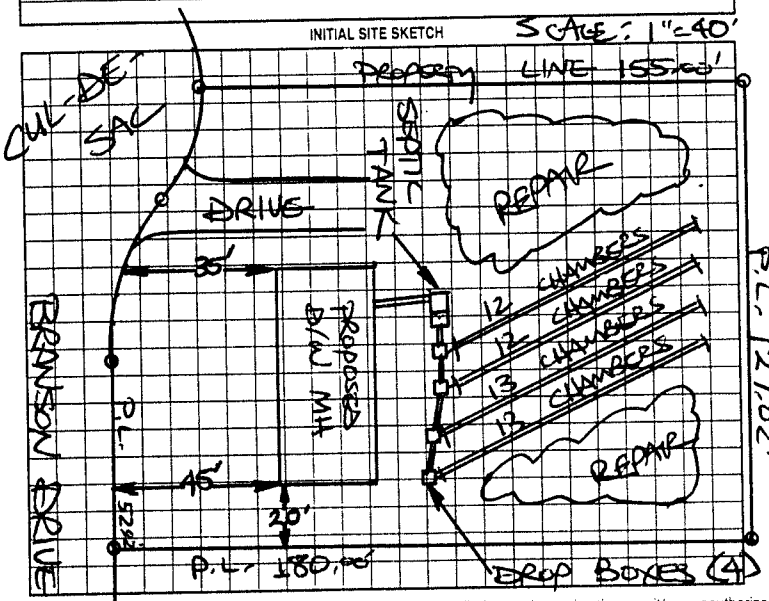

AS BUILT SKETCH

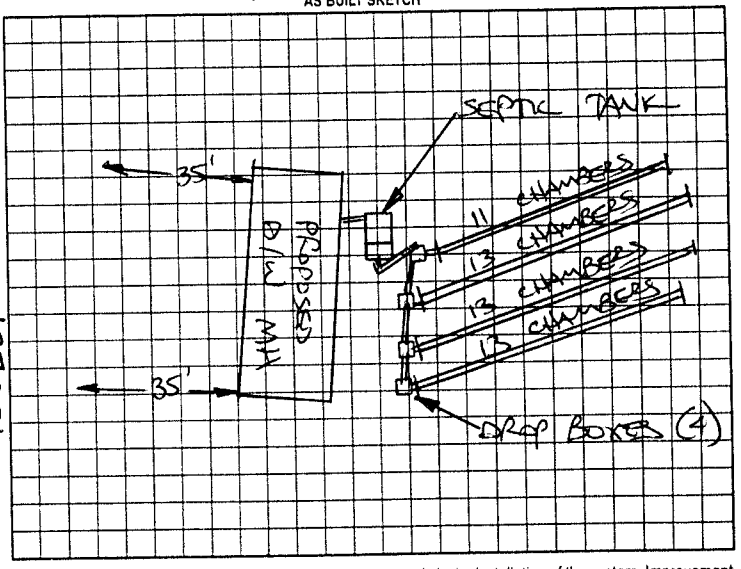

Permit can be suspended or revoked if any false information is supplied toward securing the permit/any unauthorized changes are made to the site/any unauthorized changes are made in the installation of the system. Improvement Permit with plat valid without expiration. Improvement Permit with site plan valid for sixty months. Authorization to Construct is valid for a period equal to that of Improvement Permit – not to exceed sixty months.

Signed: [signature] date 5/9/01

Improvement Permit by: STEVE HEDRICK date 4-25-01

Authorization to Construct by: STEVE HEDRICK date 4-25-01

Installed by: BOB'S BACKHOE

Operation Permit by: STEVE HEDRICK date 11-1-01

Existing System Inspection by: date

HEALTH DEPT. COPY: WHITE OWNER COPY (FINAL): YELLOW OWNER COPY (INITIAL): PINK