IREDELL COUNTY HEALTH DEPARTMENT

STATESVILLE 704-878-5305 (2nd) MOORESVILLE 704-664-5281 (1st)

IMPROVEMENT PERMIT / AUTHORIZATION TO CONSTRUCT / OPERATION PERMIT / EXISTING SYSTEM INSPECTION

PERMIT # 161579 PIN # 4860452733 4417 DATE 7-6-10

OWNER or APPLICANT (America's Home Place) PAUL SHELTON PHONE: Business 704 746 7094 Home:

OWNER or APPLICANT ADDRESS 1206 Greenland Drive

LOCATION / DIRECTIONS 77N, (R) on Tomlin Mill, (L) on Taber, (L) on Duncan at end of Duncan.

SUBDIVISION BLOCK / SECTION LOT # LOT AREA DESIGN FLOW 360 L.T.A.R. .25

Septic Tank 1000 Gallons: STB 1012 Date 5-19-10
Pump Tank Gallons: P T Date
Pump Make Model Serial #
Nitrification Field No Fields 1 No Lines 3 Linear Feet 360
Trench Width 3 Max. Trench Bottom Depth Gravel Depth

☒ New System ☐ Repair ☐ Expansion System Type I II III IV V VI
System Description: 25% Reduction Gravity
Repair System Description: 25% Reduction Gravity
Maintenance Agreement Required ☐ YES ☒ NO
☒ GRAVITY ☐ PRESSURE


☒ Residence No. Bedrooms 3
☐ Business No. Persons
☐ Other No. Employees
☐ Slab ☐ Crawl Space
☒ Basement w/plumbing ☐ Basement w/o plumbing

Water Supply: ☒ Private ☐ Public ☐ Community


Comments / Conditions

Comments / Conditions

INITIAL SITE SKETCH

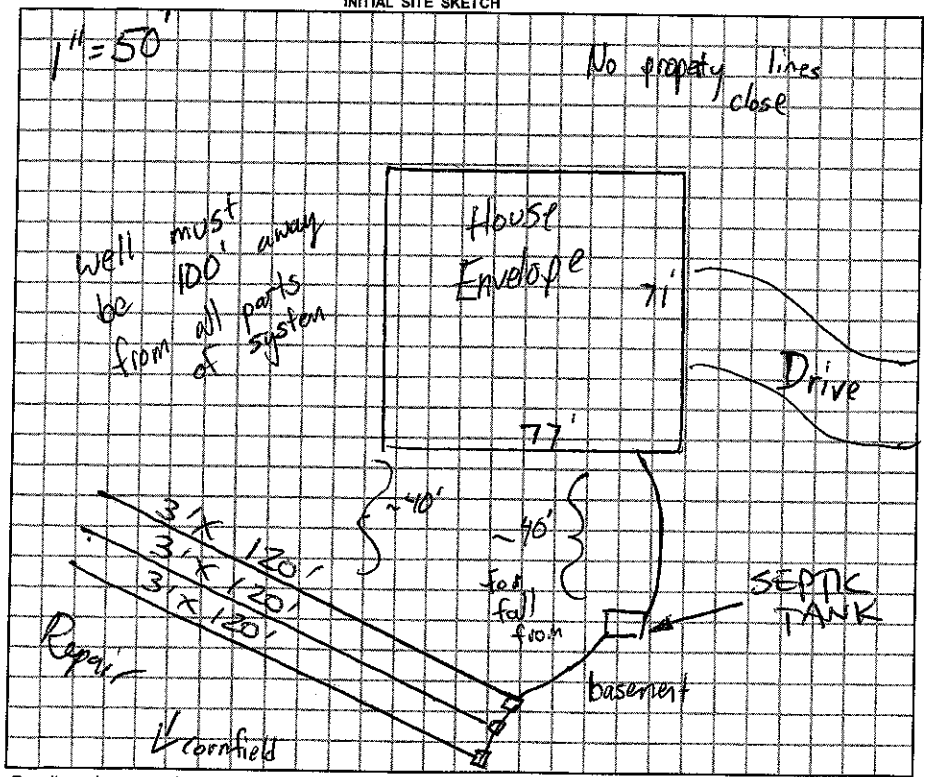

AS BUILT SKETCH

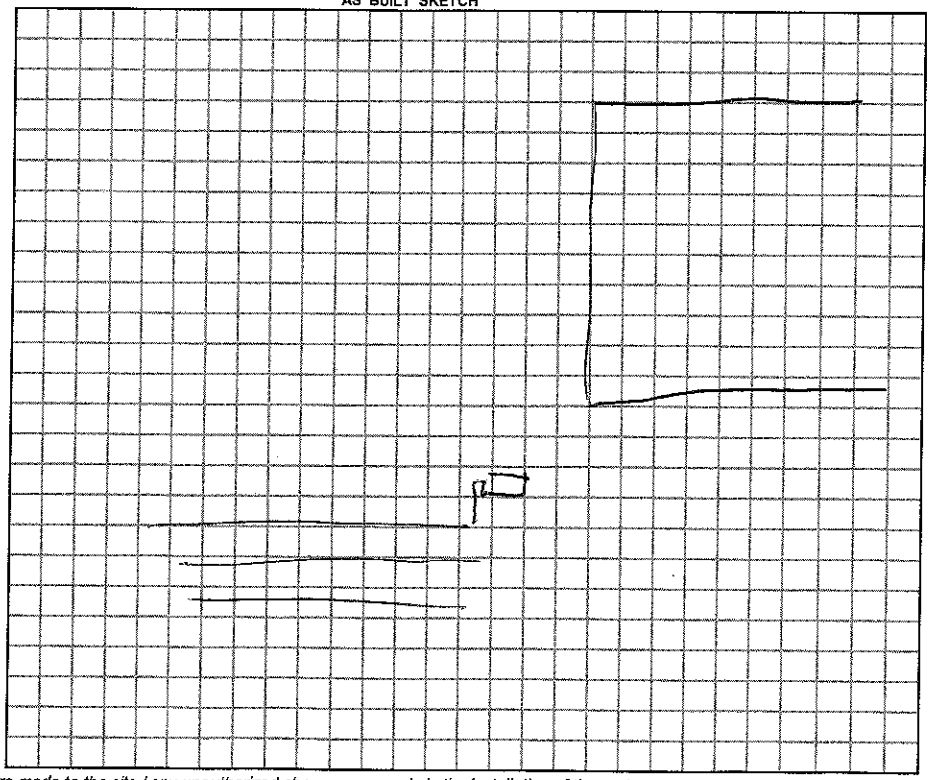

Permit can be suspended or revoked if any false information is supplied toward securing the permit / any unauthorized changes are made to the site / any unauthorized changes are made in the installation of the system.

☐ *IMPROVEMENT PERMIT w / plat valid without expiration.* ☒ *IMPROVEMENT PERMIT w / site plan valid for 60 mos.* ☒ *AUTHORIZATION TO CONSTRUCT valid for period equal to IMPROVEMENT PERMIT-not to exceed 60 mo.*

Owner / Applicant Signature: Date 7/7/10

Improvement Permit by: Date 7-6-10

Authorzation to Construct by: Date 7-6-10

Installed by: Groundbreakers

Operation Permit by: Date: 7-12-10

Existing System Inspected by: Date:

YOU SHOULD CONTACT A LOCATOR SERVICE PRIOR TO ANY EXCAVATION.

WHITE COPY Environmental Health YELLOW COPY (Final) Owner / Applicant PINK COPY (Initial) Owner / Applicant