ICHD - ENVIRONMENTAL HEALTH DIVISION

Statesville Office (704) 878-5305 Mooresville Office (704) 660-3625 PERMIT # OSWP-2023-38070

MW

SEPTIC: IMPROVEMENT PERMIT / AUTHORIZATION TO CONSTRUCT / OPERATION PERMIT / EXISTING SYSTEM / Repair PIN # 4860 -- 45 -- 9645

APPLICANT/OWNER: LARA MECIMORE APPLICANT ADDRESS: 139 DUNCAN ROAD, OLIN, N.C. 28660

SITE ADDRESS: 139 DUNCAN ROAD, OLIN, N.C. 28660 PHONE: 704-402-9018 ALT. PHONE 704-498-7806

SITE DIRECTIONS: (N) ON 21, (L) ON TABOR, (L) ON DUNCAN, LOT ON (L) SAP CONTROLLED: ☐ YES ☐ NO EXT


SUBDIVISION: — SECTION: — LOT # — LOT AREA: 1.698 AC DESIGN FLOW: EXT L.T.A.R.: EXT

Septic Tank	1000	(gal)	STB		Date		☐ New System	☑ Repair	☐ Expansion	System Type: I (II) III IV V VI
Pump Tank	—	(gal)	PT	—	Date	—	System Description:	EXISTING - CONVENTIONAL		
Pump Make	—	Model	—		Serial #	—	Repair System Description:	TANK REPLACEMENT		
# Nitrification Fields	EXT	# Lines	EXT		Linear Ft	EXT	Maintenance Agreement Required:	☐ YES	☑ NO	
Trench Width	EXT	Trench Bottom Depth(Low side)	EXT		Gravel Depth	EXT	☑ GRAVITY	☐ PRESSURE		

☑ Residence	No. Bedrooms	EXT	**Water Supply**
☐ Business	No. Persons	EXT	☑ Private EXISTING
☐ Other	No. Employees	—	☐ Public
☐ Slab	☑ Crawl Space		☐ Community
☐ Basement w/ plumbing	☐ Basement w/o plumbing		

Comments / Conditions: PUMP, CRUSH, AND FILL EXISTING SEPTIC TANK, INSPECT AND REPLACE EXISTING DISTRIBUTION DEVICES AS NEEDED, SEE NOTE REGARDING WELL SET-BACK, DRAINLINES DRY AT TIME OF INSPECTION.

INITIAL SITE SKETCH

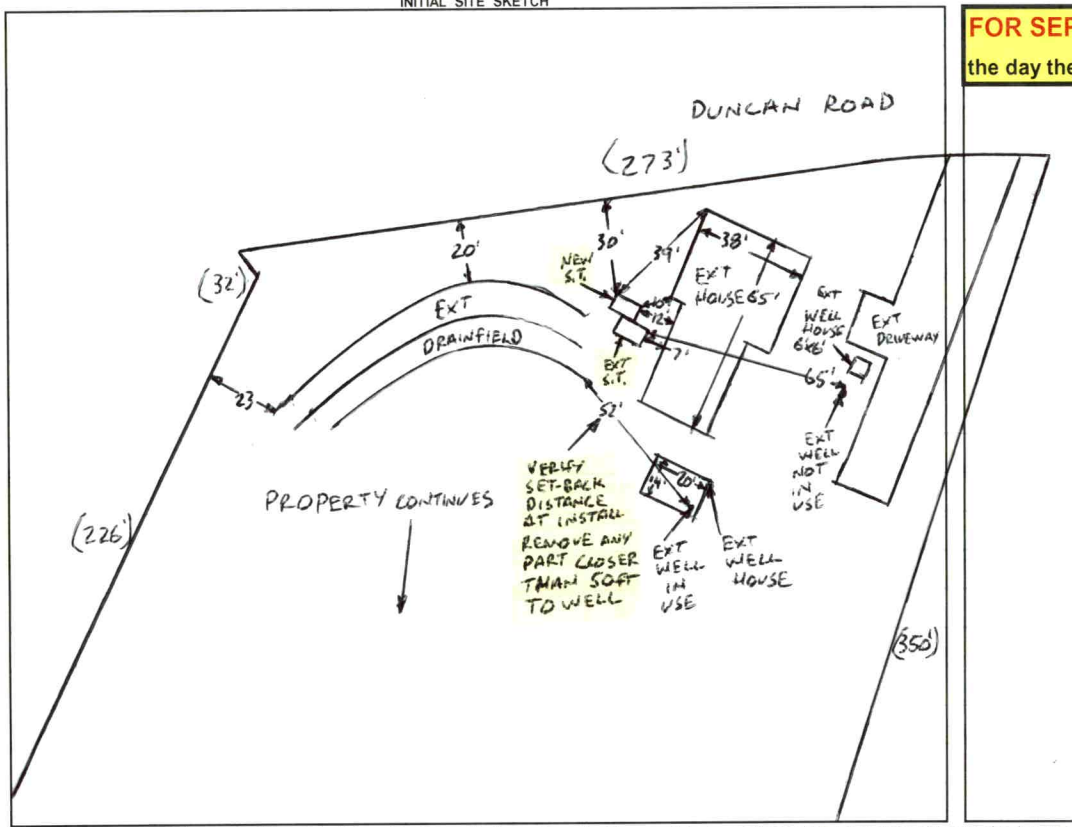

AS BUILT SKETCH

FOR SEPTIC FINAL INSPECTION CALL: 704-664-3703 between 8am-9am the day the inspection is needed. Be sure to speak with an inspector to confirm your time.

Installed as drawn.

1 IN = 60FT
S.T. = SEPTIC TANK
EXT = EXISTING

Permit can be suspended or revoked if any false information is supplied toward securing the permit / any unauthorized changes are made to the site / any unauthorized changes are made in the installation of the system. **CONTACT A LOCATOR SERVICE PRIOR TO ANY EXCAVATION**

☐ **IMPROVEMENT PERMIT** ***with plat*** *valid without expiration.* ☑ **IMPROVEMENT PERMIT** ***with site plan*** *valid for 60 mos.* ☑ **AUTHORIZATION TO CONSTRUCT** *valid for period equal to IMPROVEMENT PERMIT--not to exceed 60 mo.*

Owner / Applicant Signature: ONLINE SIGNATURE Date: — Installed by: STEVE JORDAN

IMPROVEMENT PERMIT by: Bryant C. White Date: 10-18-2023 OPERATION PERMIT by: Sarah Williams Date: 10/19/2023

AUTHORIZATION TO CONSTRUCT by: Bryant C. White Date: 10-18-2023 Existing System Inspected by: Date:

FOR SEPTIC FINAL INSPECTION: CALL 704-664-3703 between 8am-9am the day the inspection is needed.

Item	Date	Initials
Drain Lines Checked		
Tanks Checked		
Pressure Manifold or Valve Box Checked		
Pressure Head Set		
Electrical Checked		
Floats Set		
Alarm Checked		
Maintenance Contract Needed? Y / N		
Comments:		

Repairs Only	
	State Code
Failing System Code	
Type of Distribution	G or P
Type of Failure/Malfunction	
Primary Cause of Failure/Malfunction	
Age of System? _____	
Initial or Repair? _____	


1429
4860-22-6562
1429
124
Duncan Rd
131
273
139
103
St outlet
St inlet
118
115
97
32
4860-55-1608
350
4860-45-9645
226
4860-45-6417
273
102
570
432
4860-54-1515
206
1 in = 60 ft

PERMIT SNAPSHOT REPORT OSWP-2023-38070 FOR IREDELL COUNTY

Permit Type: Environmental Health OSWP
Work Class: EH Septic Permit
Status: PRIORITY PERMIT
Valuation: $0.00
Project:
District: Iredell County
Square Feet: 0.00
Assigned To: White, Bryant
App Date: 10/02/2023
Exp Date: NOT AVAILABLE
Completed: NOT COMPLETED
Approval Expire Date:

Description: Sewage Is surfacing on the ground, need a septic repair permit.

Parcel: 4860459645.000 Main	**Address:** 139 Duncan Rd Olin, NC 28660 Main	**Zone:** RA(Residential Agricultural District)

Property Owner	Applicant/Authorized Agent
Lara Mecimore	Lara Mecimore
139 Duncan rd	139 Duncan rd
Olin, NC 28660-9413	Olin, NC 28660-9413

704-498-7806
704-402-9018

Permit Custom Fields


How is your site plan being submitted	Custom Site Plan	Septic Application/Permit Type	Repair	Does the site contain any jurisdictional wetlands	No
Non-domestic Sewage Generated	No	Other Public Agency	No	All proposed structure dimensions	unknown
Maximum Number of Bedrooms	4	If other Addition/Structure, please explain		Number of Occupants	4
Foundation Type	Crawl Space Foundation	Residential/Business/Other	Residential	Water Supply	Existing Well
Desired Septic System Type	Conventional (most common)	Additional Unique Setbacks Apply	No		

Attachment File Name	Added On	Added By	Attachment Group	Notes
Signature_Lara_Mecimore_10/2/2023.jpg	10/02/2023 19:13	Mecimore, Lara		Uploaded via CSS

Workflow Step / Action Name	Action Type	Start Date	End Date
Application Completeness Check v.1		10/03/2023 8:05	10/03/2023 8:06
Confirm application complete v.1	Generic Action		10/03/2023 8:06
Environment Health Inspections v.1			
Operation Permit Inspection v.1	Inspection		
OSWP Alarm Checked v.1	Inspection		
OSWP Drain Lines Checked v.1	Inspection		
OSWP Electrical Checked v.1	Inspection		
OSWP Floats Checked v.1	Inspection		
OSWP Maintenance Contract v.1	Inspection		
OSWP Pressure Head Checked v.1	Inspection		
OSWP Pressure Manifold Checked v.1	Inspection		
OSWP Tanks Checked v.1	Inspection		
~~**Zoning Review v.1**~~			10/03/2023 8:05
~~Floodplain Admin Overview v.1~~	Task		10/03/2023 8:05
~~Issue Invoice v.1~~	Generic Action		10/03/2023 8:05
~~Fees Paid v.1~~	Generic Action		10/03/2023 8:05
Fees v.1			
Issue Invoice v.1	Generic Action		
Fees Paid v.1	Generic Action		
Lot Readiness Verification v.1			

PERMIT SNAPSHOT REPORT (OSWP-2023-38070)

OSWP Septic Preliminary Site Visit v.1	Inspection
OSWP Site Evaluation v.1	Inspection
Issue Improvement Permit v.1	
Issue Invoice v.1	Generic Action
Fees Paid v.1	Generic Action
Issue Permit v.1	Generic Action
Permit Completion Process v.1	
Authorization to Construct Permit v.1	Create Sub Permit
Issue Authorization to Construct v.1	Generic Action

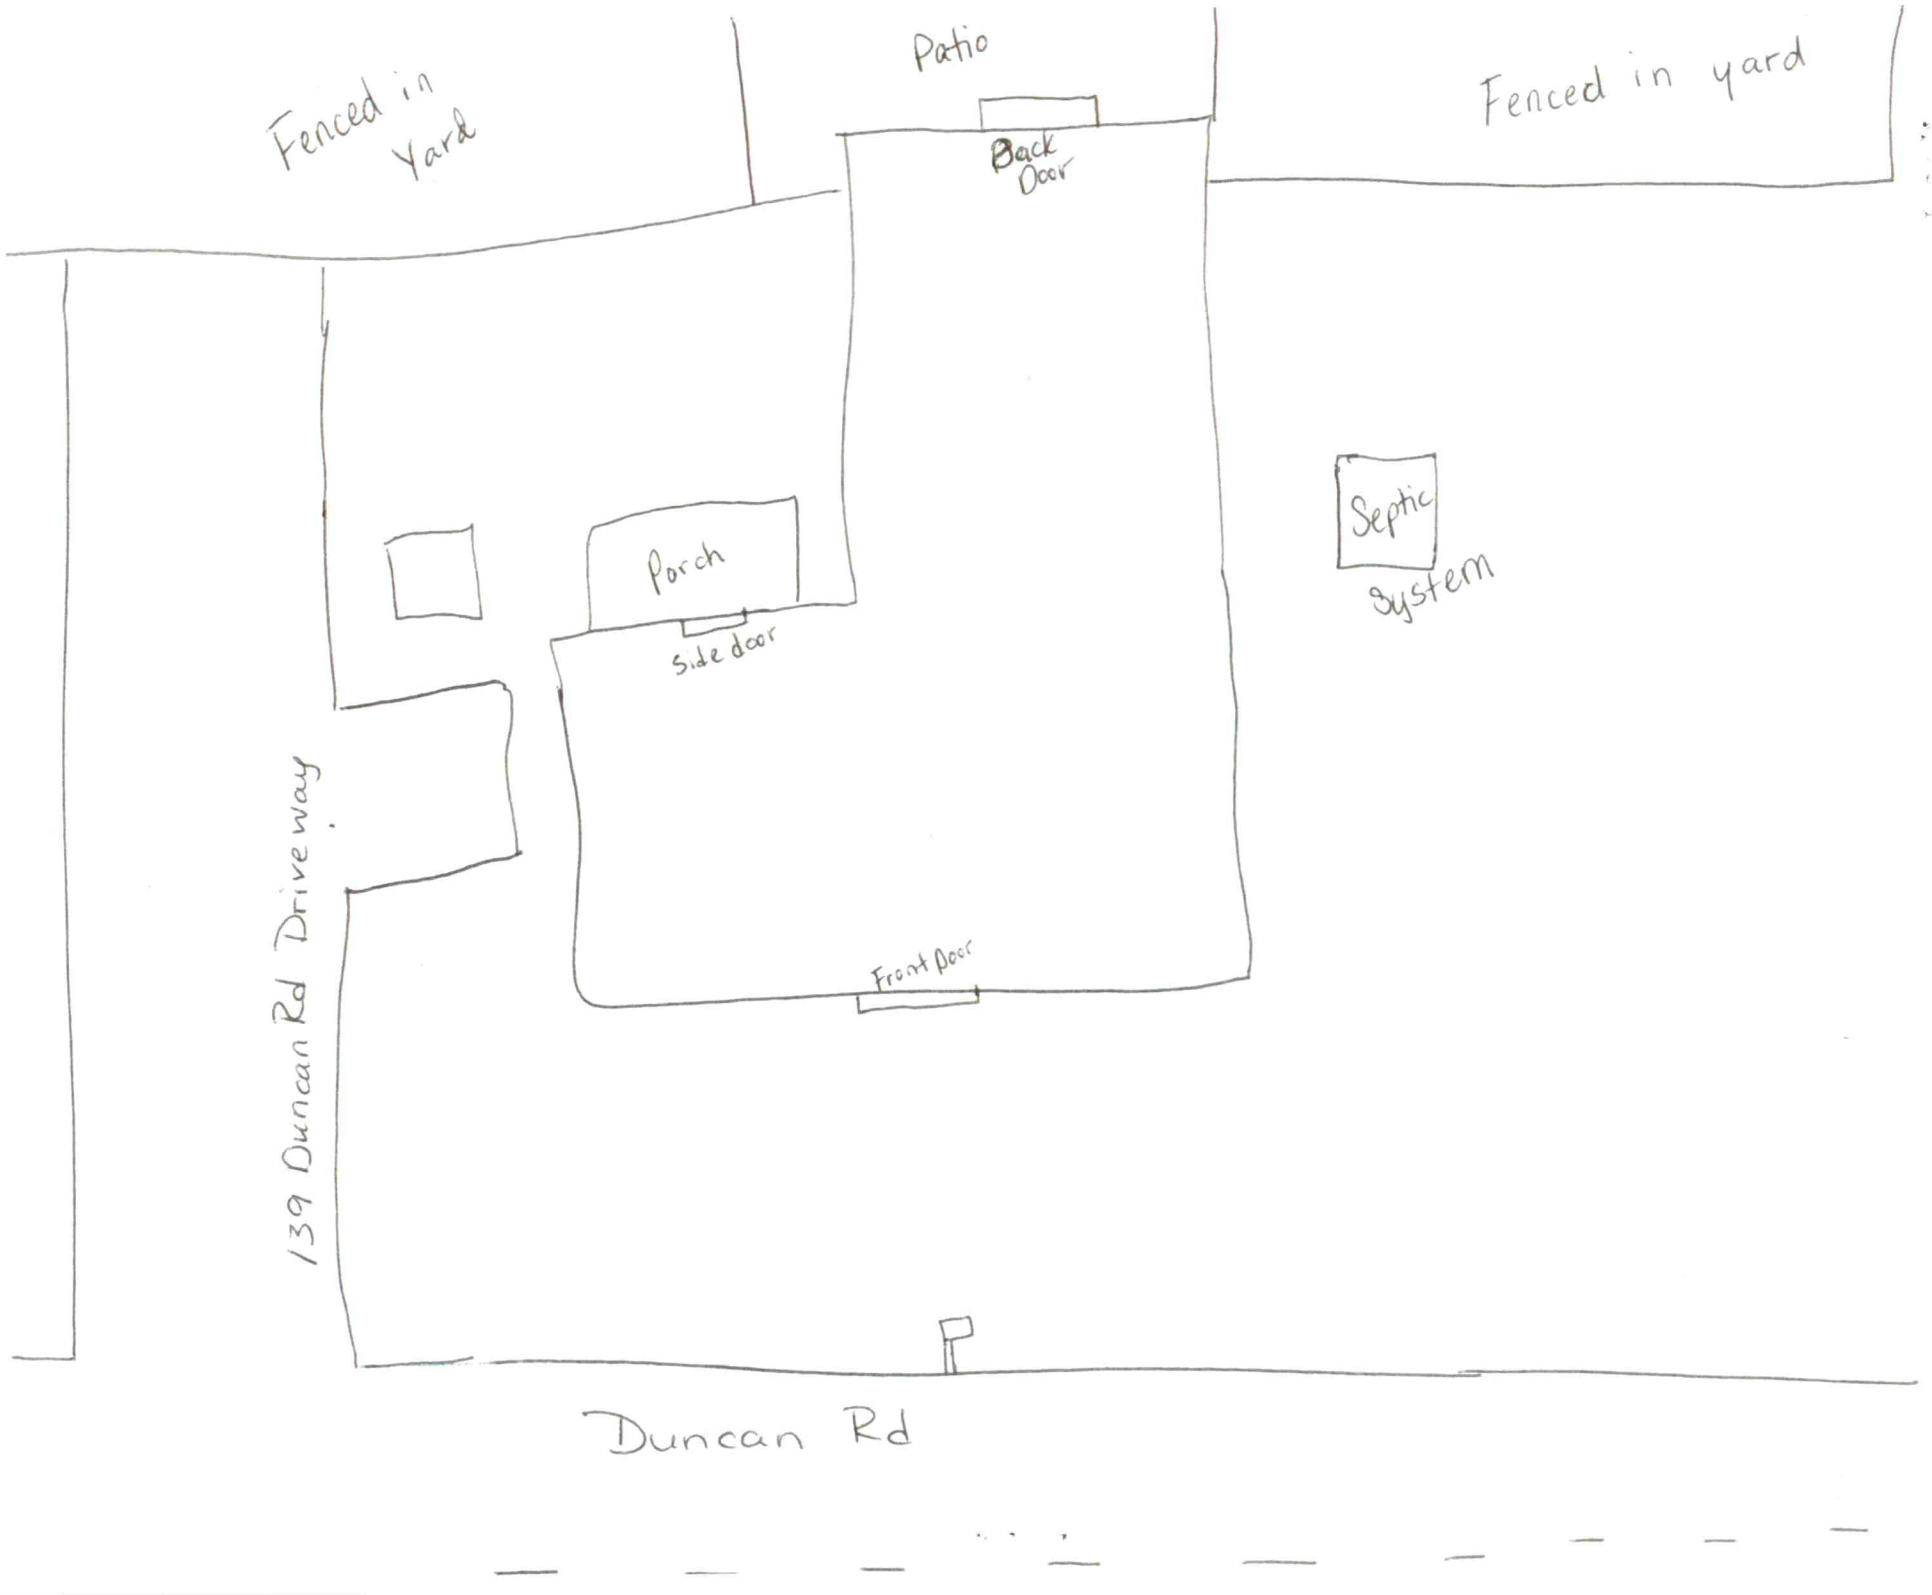
Fenced in Yard
Patio
Back Door
Fenced in yard
Porch
Side door
Septic System
139 Duncan Rd Driveway
Front Door
Duncan Rd