IREDELL COUNTY HEALTH DEPARTMENT

STATESVILLE 704-878-5305 MOORESVILLE 704-664-5281

IMPROVEMENT PERMIT / AUTHORIZATION TO CONSTRUCT / OPERATION PERMIT / EXISTING SYSTEM INSPECTION

CF

PERMIT# 088790 PIN# 4860 398531 DATE 5-24-01

OWNER OR CONTRACTOR WHITEWOLF PROPERTIES PHONE: Business (704) 532-6625 Home

ADDRESS 5551 MONROE ROAD CHARLOTTE NC 28212

LOCATION US 21 NORTH, TL TABOR ROAD, TL CANFIELD DRIVE 6TH LOT ON RIGHT

SUBDIVISION HEATHSTEAD BLOCK / SECTION LOT 6 LOT AREA 1.12 ACRE SITE CLASS PS DESIGN FLOW 360 L.T.A.R. 0.25 GPD/FT²

Septic Tank: 1000 Gallons; STB 794 Date 3-15-02
Pump Tank: Gallons; PT Date
Pump Make: Model Serial No.
Nitrification Field: No Fields 1 Square Feet EQ.T 1440 Linear Feet 360+
No Lines FOUR Trench Width 36" Max Trench Bottom Depth 36" Gravel Depth N/A

☑ New System ☐ Repair System Type: I, II, III, IV, V, VI
System Description: 25% REDUCTION, GRAVITY
Repair System Description: 25% REDUCTION, PUMP
Maintenance Agreement Required: ☐ Yes ☑ No


☐ House/Mod. Home ☑ Mobile Home ☐ Business ☐ Other
No. Bedrooms 3 No. Bathrooms 2 No. Employees
☐ Slab ☑ Crawl Space ☐ Basement w/plumbing ☐ Basement wo/plumbing

Water Supply: ☐ Individual ☑ Public ☐ Community

Comments/Conditions: ① INSTALL 25% REDUCTION SYSTEM USING 60 CHAMBERS (WITH CONTOUR WEDGES) OR 36 HDS SECTIONS

Comments/Conditions: ZABEL FILTER & MARKER USED HDS SECTIONS

INITIAL SITE SKETCH

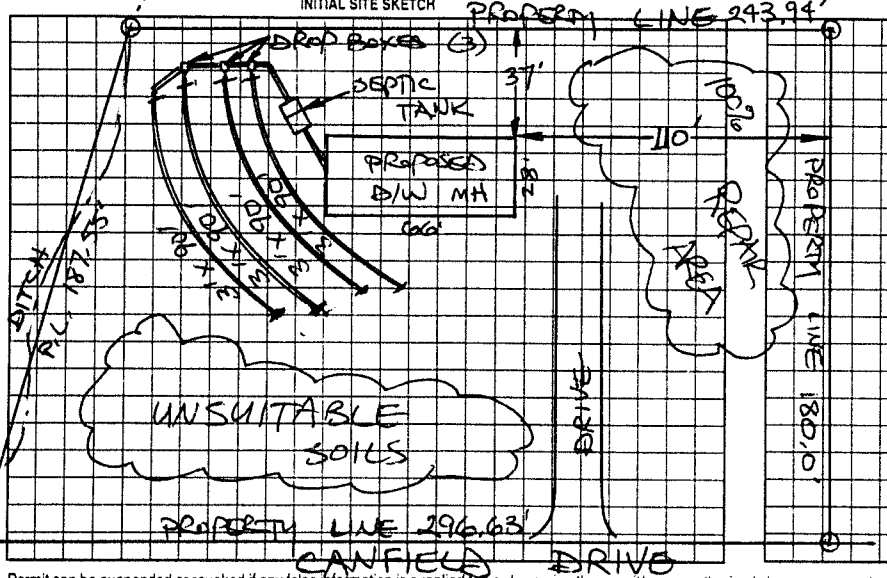

AS BUILT SKETCH

Permit can be suspended or revoked if any false information is supplied toward securing the permit/any unauthorized changes are made to the site/any unauthorized changes are made in the installation of the system. Improvement Permit with plat valid without expiration. Improvement Permit with site plan valid for sixty months. Authorization to Construct is valid for a period equal to that of Improvement Permit – not to exceed sixty months.

Signed: James T Barkley date 5-24-01 Installed by: ANDY DANIELS

Improvement Permit by: STEVE HEDRICK date 5-24-01 Operation Permit by: [signature] date 04-17-02

Authorization to Construct by: STEVE HEDRICK date 5-24-01 Existing System Inspection by: date

HEALTH DEPT COPY WHITE OWNER COPY (FINAL) YELLOW OWNER COPY (INITIAL) PINK