IREDELL COUNTY HEALTH DEPARTMENT

STATESVILLE 704-878-5305 MOORESVILLE 704-664-5281

IMPROVEMENT PERMIT / AUTHORIZATION TO CONSTRUCT / OPERATION PERMIT / EXISTING SYSTEM INSPECTION

PERMIT# 082994 PIN# 4860 39 8531 DATE 8-4-99

OWNER OR CONTRACTOR WHITE WOLF PROPERTIES PHONE: Business 532-6527 Home

ADDRESS 5551 MONROE ROAD, CHARLOTTE, NC 28212

LOCATION US 21 N, TL TABOR RD, TL CANFIELD DR, TL BRANSON DR, 1ST LOT ON LEFT

SUBDIVISION HEATHSTEAD BLOCK / SECTION LOT 32 LOT AREA 0.54 ACRE SITE CLASS PS DESIGN FLOW 360 L.T.A.R. 0.30 GPD/FT²

Septic Tank: 1000 Gallons; STB 744 Date 6-22
Pump Tank: Gallons; PT Date
Pump Make: Model Serial No.
Nitrification Field: No Fields 1 Square Feet EQ. TO 1200 Linear Feet 300+
No Lines FOUR Trench Width 36" Max Trench Bottom Depth 36" Gravel Depth 6" SAND

✓ New System ☐ Repair System Type: I, II, III, IV, V, VI
System Description: 25% REDUCTION GRAV.
Repair System Description: 25% REDUCTION PUMP
Maintenance Agreement Required: ☐ Yes ✓ No


✓ House/Mod. Home No. Bedrooms 3
✓ Mobile Home No. Bathrooms 2
☐ Business No. Employees
☐ Other
☐ Slab ✓ Crawl Space ☐ Basement w/plumbing ☐ Basement wo/plumbing

Water Supply: ☐ Individual ✓ Public ☐ Community

Comments/Conditions: INSTALL 25% REDUCTION SYSTEM USING FIFTY (50) CHAMBERS OR THIRTY (30) HDS SECTIONS AS PLACED ON CONTOUR

Comments/Conditions

INITIAL SITE SKETCH SCALE: 1" = 40'

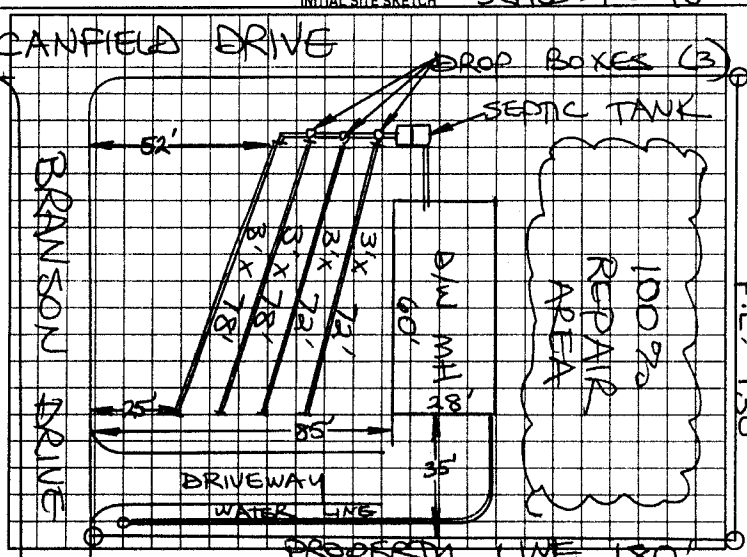

AS BUILT SKETCH

Installed as shown

Permit can be suspended or revoked if any false information is supplied toward securing the permit any unauthorized changes are made to the site/any unauthorized changes are made in the installation of the system. Improvement Permit with plat valid without expiration. Improvement Permit with site plan valid for sixty months. Authorization to Construct is valid for a period equal to that of Improvement Permit – not to exceed sixty months.

Signed: James V. Bachelor date 8-5-99 Installed by: Gum Enterprise

Improvement Permit by: STEVE HEDRICK date 8-4-99 Operation Permit by: Mat C. Offs date 8-10-99

Authorization to Construct by: STEVE HEDRICK date 8-4-99 Existing System Inspection by: date

HEALTH DEPT COPY WHITE OWNER COPY (FINAL) YELLOW OWNER COPY (INITIAL) PINK