IREDELL COUNTY HEALTH DEPARTMENT

STATESVILLE 704-878-5305 MOORESVILLE 704-664-5281

IMPROVEMENT PERMIT / AUTHORIZATION TO CONSTRUCT / OPERATION PERMIT / EXISTING SYSTEM INSPECTION

PERMIT# 084120 PIN# 4860 39 8531 (PART) DATE 10-26-99

OWNER OR CONTRACTOR WHITE WOLF PROPERTIES PHONE: Business (704) 532-6625 Home

ADDRESS 5551 MONROE ROAD, CHARLOTTE, NC 28212

LOCATION US 21 NORTH, TL TABOR ROAD, TL CANFIELD DRIVE, 3RD LOT ON LEFT

SUBDIVISION HEATHSTEAD BLOCK / SECTION LOT 36 LOT AREA 1.10 ACRES SITE CLASS PS DESIGN FLOW 360 L.T.A.R. 0.30 GPD/FT²

Septic Tank: 1000 Gallons; STB 354 Date 8/18/00
Pump Tank: Gallons; PT Date
Pump Make: Model Serial No
Nitrification Field: No Fields 4 Square Feet 1200 Linear Feet 400
No Lines FOUR Trench Width 36" Max Trench Bottom Depth 36" Gravel Depth 12"

☑ New System ☐ Repair System Type: I II III IV V VI
System Description: CONVENTIONAL GRAVITY
Repair System Description: CONVENTIONAL GRAVITY
Maintenance Agreement Required: ☐ Yes ☑ No

☐ House/Mod. Home ☑ Mobile Home ☐ Business ☐ Other
No. Bedrooms 3 No. Bathrooms 2 No. Employees


☐ Slab ☑ Crawl Space ☐ Basement w/plumbing ☐ Basement wo/plumbing

Water Supply: ☐ Individual ☑ Public ☐ Community

Comments/Conditions:


PROPERTY LINE 235.46'

INITIAL SITE SKETCH

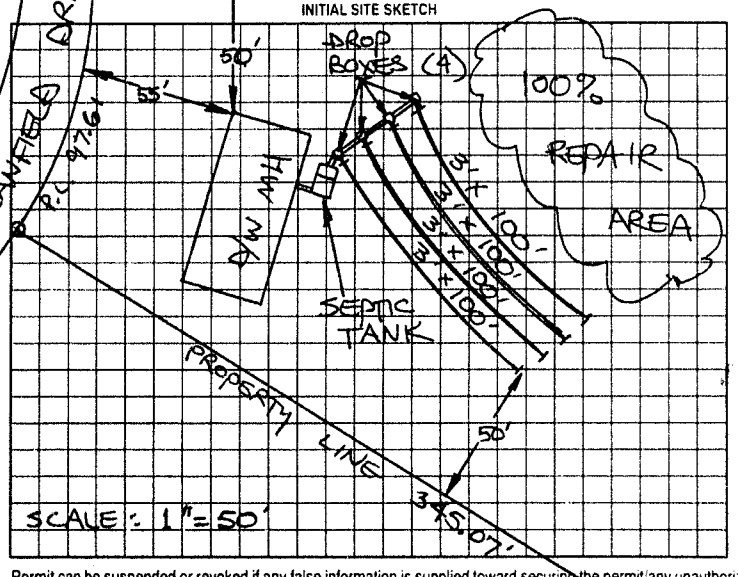

Comments/Conditions

AS BUILT SKETCH

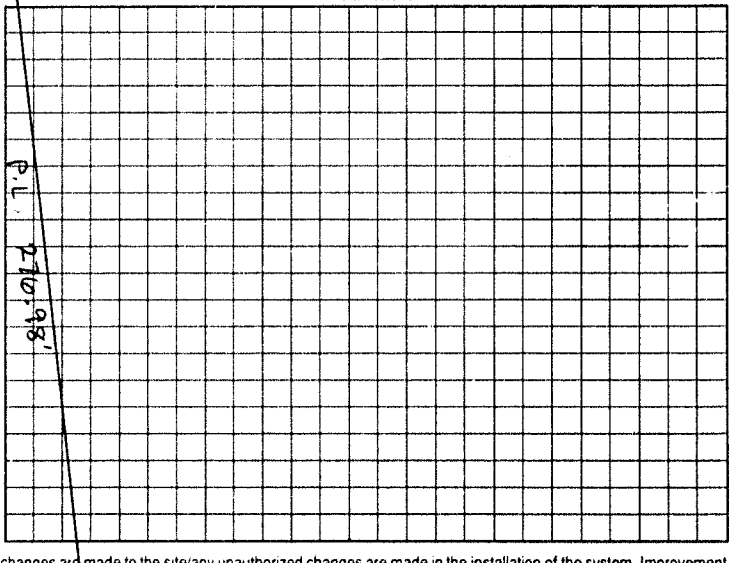

Permit can be suspended or revoked if any false information is supplied toward securing the permit/any unauthorized changes are made to the site/any unauthorized changes are made in the installation of the system. Improvement Permit with plat valid without expiration. Improvement Permit with site plan valid for sixty months. Authorization to Construct is valid for a period equal to that of Improvement Permit - not to exceed sixty months.

Signed: [signature] date 11-5-99 Installed by: Gam Enterprises

Improvement Permit by: STEVE HEDRICK date 10-26-99 Operation Permit by: [signature] date 10/10/00

Authorization to Construct by: STEVE HEDRICK date 10-26-99 Existing System Inspection by: date

HEALTH DEPT COPY WHITE OWNER COPY (FINAL) YELLOW OWNER COPY (INITIAL) PINK