IREDELL COUNTY HEALTH DEPARTMENT

STATESVILLE 704-878-5305 MOORESVILLE 704-664-5281

IMPROVEMENT PERMIT / AUTHORIZATION TO CONSTRUCT / OPERATION PERMIT / EXISTING SYSTEM INSPECTION

PERMIT# 88788 PIN# 4860398531 DATE 10/10/00

OWNER OR CONTRACTOR White Wolf Prop. PHONE: Business (704) 532-6525 Home

ADDRESS 5551 Monroe Rd. Charlotte NC 28212

LOCATION 2 N, L Taber, L Corn Field on RT

SUBDIVISION Heathsted BLOCK / SECTION LOT 4 LOT AREA .65 SITE CLASS P5 DESIGN FLOW 360 L.T.A.R. 0.3

Septic Tank: 1000 Gallons; STB 354 Date 1-9-01
Pump Tank: Gallons; PT Date
Pump Make: Model Serial No.
Nitrification Field: No Fields 1 Square Feet 1200 Linear Feet 400
No Lines 4 @ 100' Trench Width 36" Max Trench Bottom Depth 36" Gravel Depth 12"

☒ New System ☐ Repair System Type: I (II) III. IV. V. VI
System Description: Gravity Conv.
Repair System Description: Gravel / Prop. conv.
Maintenance Agreement Required: ☐ Yes ☒ No


☐ House/Mod. Home ☒ Mobile Home ☐ Business ☐ Other
No. Bedrooms 3 No. Bathrooms 2 No. Employees
☐ Slab ☒ Crawl Space ☐ Basement w/plumbing ☐ Basement wo/plumbing

Water Supply: ☐ Individual ☒ Public ☐ Community

Comments:/Conditions:

Comments:/Conditions: SEPTIC TANK WITH MARKER INSTALLED USING "POLYLOK" FILTER

INITIAL SITE SKETCH

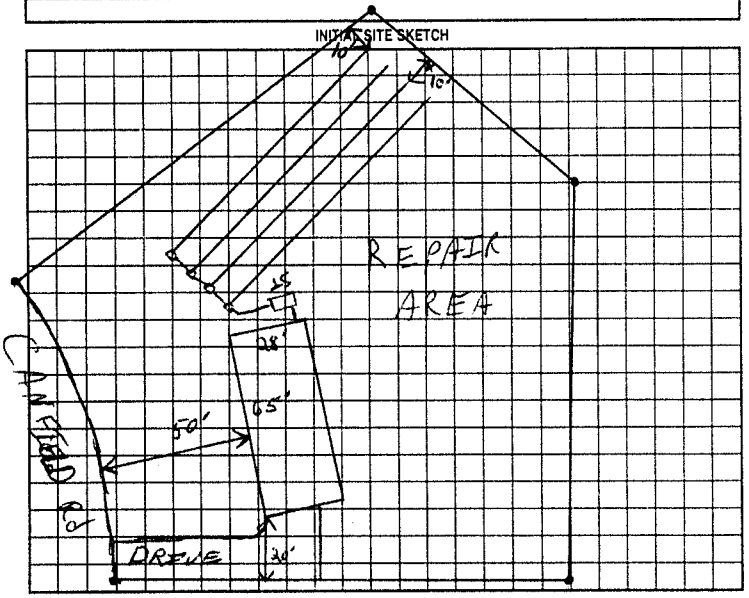

AS BUILT SKETCH

SYSTEM INSTALLED ACCORDING TO INITIAL SITE SKETCH

Permit can be suspended or revoked if any false information is supplied toward securing the permit/any unauthorized changes are made to the site/any unauthorized changes are made in the installation of the system. Improvement Permit with plat valid without expiration. Improvement Permit with site plan valid for sixty months. Authorization to Construct is valid for a period equal to that of Improvement Permit – not to exceed sixty months.

Signed: T Shane Bohelr date 10/15/00

Improvement Permit by: [signature] RSE date 10/10/00

Authorization to Construct by: [signature] RSE date 10/10/00

Installed by: G & M ENT.

Operation Permit by: STEVE HEDRICK date 4-4-01

Existing System Inspection by: date

HEALTH DEPT. COPY WHITE OWNER COPY (FINAL) YELLOW OWNER COPY (INITIAL) PINK