# IREDELL COUNTY HEALTH DEPARTMENT

STATESVILLE 704-878-5305 MOORESVILLE 704-664-5281

## IMPROVEMENT PERMIT / AUTHORIZATION TO CONSTRUCT / OPERATION PERMIT / EXISTING SYSTEM INSPECTION

PERMIT# 090402 PIN# 4860 39 9531 DATE 7-7-2000

OWNER OR CONTRACTOR WHITE WOLF PROP. PHONE: Business 532-6625 Home

ADDRESS 5551 MONROE ROAD, CHARLOTTE, NC 28212

LOCATION US 21 N, TL TABOR RD, TL CANFIELD DRIVE, 2ND LOT ON LEFT

SUBDIVISION HEATHSTEAD BLOCK / SECTION LOT 37 LOT AREA 0.76 ACRE SITE CLASS PS DESIGN FLOW 360 L.T.A.R. 0.30 GPD/FT²

Septic Tank: 1000 Gallons; STB 821 Date 6-16-00
Pump Tank: Gallons; PT Date
Pump Make: Model Serial No.
Nitrification Field: No Fields 1 Square Feet 1200 Linear Feet 400
No Lines FIVE Trench Width 36" Max Trench Bottom Depth 30"

☑ New System ☐ Repair System Type: I (II) III. IV. V. VI
System Description: CONVENTIONAL GRAVITY
Repair System Description: 25% REDUCTION GRAVITY
Maintenance Agreement Required: ☐ Yes ☑ No
Gravel Depth 12" ☐ Slab ☑ Crawl Space ☐ Basement w/plumbing ☐ Basement wo/plumbing

☐ House/Mod. Home ☑ Mobile Home ☐ Business ☐ Other
No. Bedrooms 3 No. Bathrooms 2 No. Employees


Water Supply: ☐ Individual ☑ Public ☐ Community

Comments/Conditions:


Comments/Conditions:

SCALE: 1"=50'

INITIAL SITE SKETCH

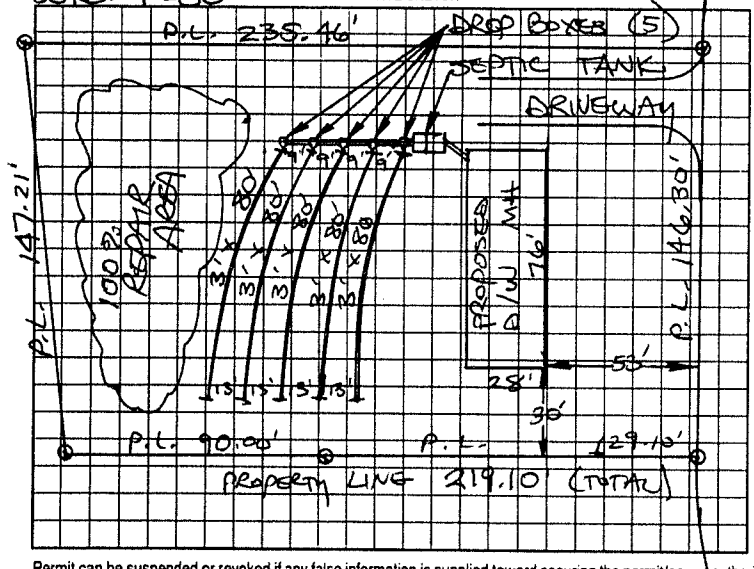


AS BUILT SKETCH

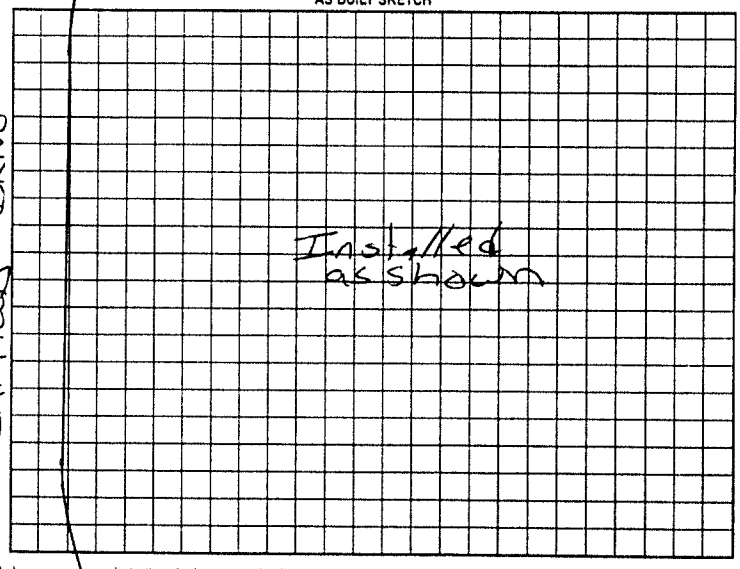


Permit can be suspended or revoked if any false information is supplied toward securing the permit/any unauthorized changes are made to the site/any unauthorized changes are made in the installation of the system. Improvement Permit with plat valid without expiration. Improvement Permit with site plan valid for sixty months. Authorization to Construct is valid for a period equal to that of Improvement Permit – not to exceed sixty months.

Signed: date 7-7-2000 Installed by: G+M

Improvement Permit by: STEVE HEDRICK date 7-7-2000 Operation Permit by: date 7-18-00

Authorization to Construct by: STEVE HEDRICK date 7-7-2000 Existing System Inspection by: date

HEALTH DEPT. COPY: WHITE OWNER COPY (FINAL): YELLOW OWNER COPY (INITIAL): PINK