IREDELL COUNTY HEALTH DEPARTMENT

STATESVILLE 704-878-5305 (E) MOORESVILLE 704-664-5281

(L) **IMPROVEMENT PERMIT / AUTHORIZATION TO CONSTRUCT / OPERATION PERMIT / EXISTING SYSTEM INSPECTION**

PERMIT# 108333 PIN# 4860-49-7636 DATE 8-27-02

OWNER OR CONTRACTOR CAROLINA LIFESTYLE HOUSING, INC PHONE Business 336-751-4923 Home

ADDRESS 130 CANFIELD DR OLIN, NC 28660

LOCATION US 21 NORTH, TL TABOR ROAD, 2ND LOT ON LEFT PAST CANFIELD DRIVE

SUBDIVISION HEATHSTEAD BLOCK / SECTION LOT 3 LOT AREA 1.40 ACRES SITE CLASS PS DESIGN FLOW 360 L T A R 0.30 GPD/FT²


Septic Tank: 1000 Gallons STB 760 Date 6-15-02	✓New System Repair System Type I II III IV V	House/Mod Home No Bedrooms 3	Water Supply: ✓Individual ☐Public ☐Community
Pump Tank: Gallons PT Date	System Description: CONVENTIONAL, GRAVITY	✓Mobile Home No Bathrooms 2	
Pump Make: Model Serial No	Repair System Description: CONVENTIONAL, GRAVITY	Business No Employees	WELL
Nitrification Field: No Fields 1 Square Feet 1200 Linear Feet 400	Maintenance Agreement Required Yes ✓No	Other	
No Lines FIVE Trench Width 36" Max Trench Bottom Depth 36"	Gravel Depth 12" Slab ✓Crawl Space	Basement w/plumbing	Basement wo/plumbing

Comments/Conditions:


KEEP SYSTEM MINIMUM 50' FROM WELLS.

Comments/Conditions: SEPTIC TANK W/ RISERS & MARKER INSTALLED USING "ZABEL" FILTER

INITIAL SITE SKETCH

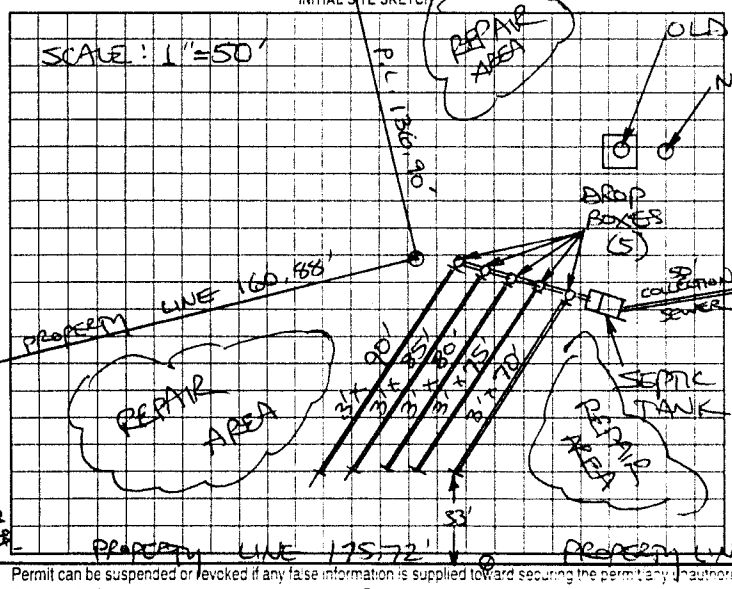

AS BUILT SKETCH

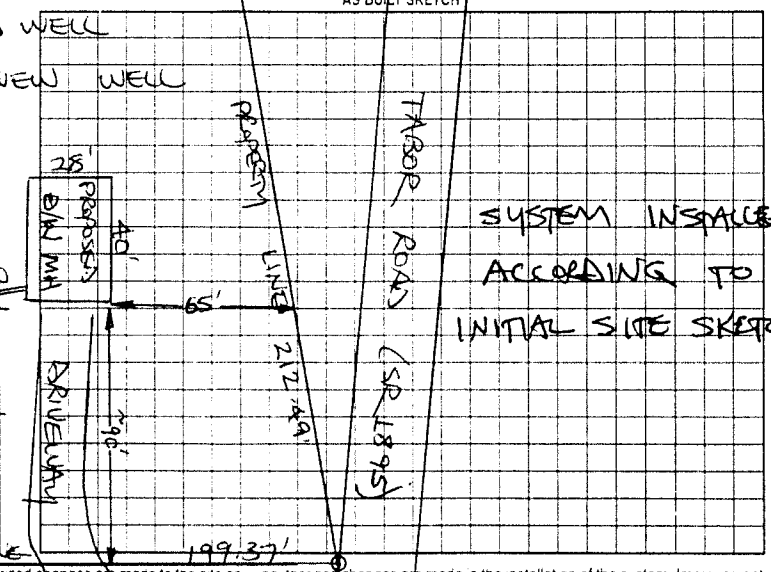

SYSTEM INSTALLED ACCORDING TO INITIAL SITE SKETCH

Permit can be suspended or revoked if any false information is supplied toward securing the permit any unauthorized changes are made to the site any unauthorized changes are made in the installation of the system. Improvement Permit with plat valid without expiration. Improvement Permit with site plan valid for sixty months. Authorization to Construct is valid for a period equal to that of Improvement Permit – not to exceed sixty months.

Signed: x Robert A Steele date installed by SHERMAN DUNN

Improvement Permit by: STEVE HEDRICK date 8-27-02 Operation Permit by STEVE HEDRICK date 9-18-02

Authorization to Construct by: STEVE HEDRICK date 8-27-02 Existing System Inspection by: date

HEALTH DEPT COPY WHITE OWNER COPY (FINAL) YELLOW OWNER COPY (INITIAL) PINK