IREDELL COUNTY HEALTH DEPARTMENT

STATESVILLE 704-878-5305 MOORESVILLE 704-664-5281

IMPROVEMENT PERMIT / AUTHORIZATION TO CONSTRUCT / OPERATION PERMIT / EXISTING SYSTEM INSPECTION

PERMIT# 089301 PIN# 4860398531 (pt) DATE May 22, 00

OWNER OR CONTRACTOR A1 Mobile Homes PHONE: Business 873-1614 Home

ADDRESS 590 Mocksville Hwy Statesville

LOCATION 21 N. TL Tabor Rd. ~3 miles on left @ jct w/ Canfield

SUBDIVISION Heathsted BLOCK / SECTION LOT 38 LOT AREA .61ac SITE CLASS PS DESIGN FLOW 360gpd L.T.A.R. ~3+

Septic Tank: 1000 Gallons: STB 6020 Date 5-4-2000

Pump Tank: Gallons; PT Date

Pump Make: Model Serial No.

Nitrification Field: No Fields 1 Square Feet 1200 Linear Feet 400

No Lines 5 Trench Width 36" Max Trench Bottom Depth 36"

☑ New System ☐ Repair System Type: I (II) III, IV, V, VI

System Description: Capacity Conventional

Repair System Description: Gravel pumped Innovative

Maintenance Agreement Required: ☐ Yes ☑ No

Gravel Depth 12"

☐ House/Mod Home No. Bedrooms 3

☑ Mobile Home No. Bathrooms 2

☐ Business No. Employees

☐ Other

☐ Slab ☑ Crawl Space ☐ Basement w/plumbing ☐ Basement wo/plumbing


Water Supply: ☐ Individual ☑ Public ☐ Community

Comments/Conditions:

Comments/Conditions: SEPTIC TANK W/ RISERS INSTALLED USING "TUFTITE" FILTER

INITIAL SITE SKETCH

1" = 50'

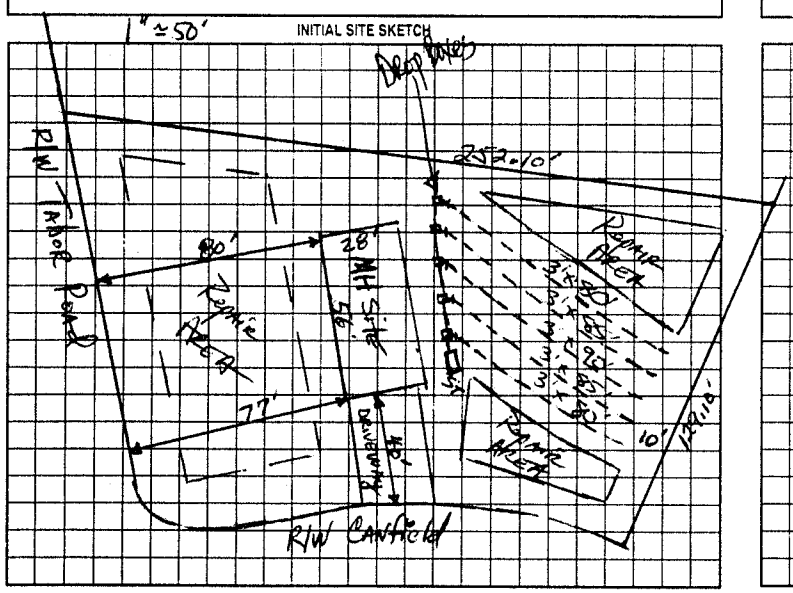

AS BUILT SKETCH

SYSTEM INSTALLED ACCORDING TO INITIAL SITE SKETCH

Permit can be suspended or revoked if any false information is supplied toward securing the permit/any unauthorized changes are made to the site/any unauthorized changes are made in the installation of the system. Improvement Permit with plat valid without expiration. Improvement Permit with site plan valid for sixty months. Authorization to Construct is valid for a period equal to that of Improvement Permit – not to exceed sixty months.

Signed: [signature] date 5-23-00 Installed by: SAMMY REAVIS

Improvement Permit by: [signature] date 5-22-00 Operation Permit by: STEVE HENDRICK date 6-6-2000

Authorization to Construct by: [signature] date 5-22-00 Existing System Inspection by: date

HEALTH DEPT. COPY. WHITE OWNER COPY (FINAL). YELLOW OWNER COPY (INITIAL) PINK