IREDELL COUNTY HEALTH DEPARTMENT

STATESVILLE 704-878-5305 MOORESVILLE 704-664-5281

IMPROVEMENT PERMIT / AUTHORIZATION TO CONSTRUCT / OPERATION PERMIT / EXISTING SYSTEM INSPECTION

PERMIT# REPAIR PIN# 4860-55-1608 DATE 11-1-02

OWNER OR CONTRACTOR Roy BALDWIN PHONE Business Home 704-546-2128

ADDRESS 131 DUNCAN ROAD, OUN, NC 28660

LOCATION US 21 N, TL TABOR ROAD, TL DUNCAN ROAD, ON LEFT AT BOX #131

SUBDIVISION JOHNSON BLOCK / SECTION LOT 2 LOT AREA 0.93 ACRE SITE CLASS PS DESIGN FLOW 360 L.T.A.R EXISTING

Septic Tank EXISTING Gallons: STB Date

Pump Tank: Gallons: PT Date

Pump Make: Model Serial No

Nitrification Field: No Fields 1 Square Feet 540 Linear Feet 180

No Lines THREE Trench Width 36" Max Trench Bottom Depth 36" Gravel Depth 18"

New System ✓ Repair System Type I

System Description:

Repair System Description CONVENTIONAL, GRAVITY

Maintenance Agreement Required Yes ✓ No

✓ House/Mod Home No Bedrooms 3

Mobile Home No Bathrooms 2

Business No Employees

Other

Slab ✓ Crawl Space Basement w/plumbing Basement wo/plumbing


Water Supply: ✓ Individual ☐ Public ☐ Community

WELL


Comments/Conditions: USE 18" STONE IN TRENCHES

Comments/Conditions

INITIAL SITE SKETCH

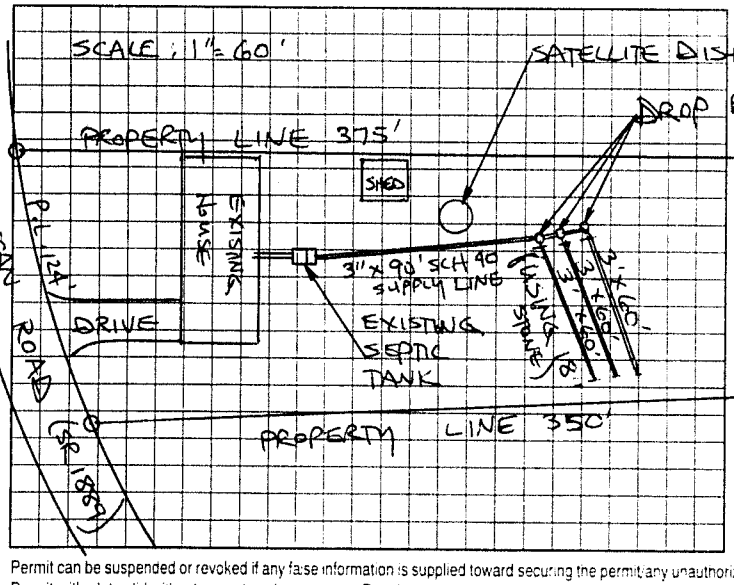

AS BUILT SKETCH

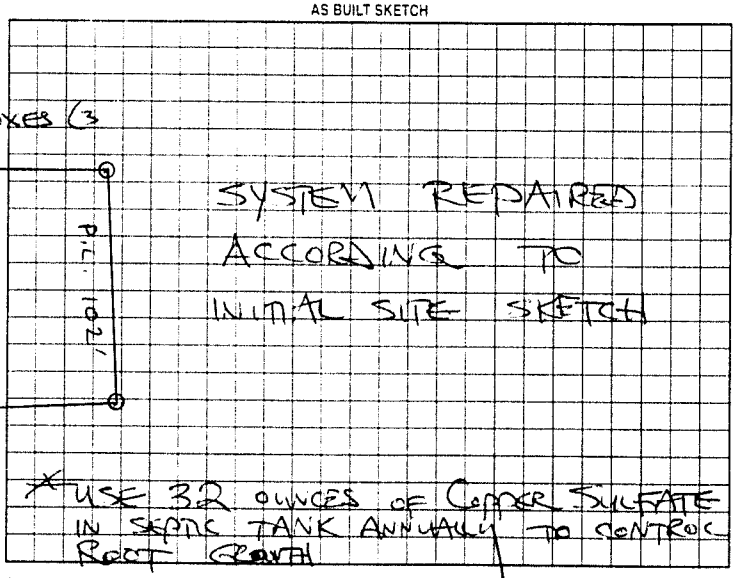

Permit can be suspended or revoked if any false information is supplied toward securing the permit; any unauthorized changes are made to the site; any unauthorized changes are made in the installation of the system. Improvement Permit with plat valid without expiration. Improvement Permit with site plan valid for sixty months. Authorization to Construct is valid for a period equal to that of Improvement Permit - not to exceed sixty months.

Signed: ✓ Roy Baldwin date 11-1-02 Installed by SAMMY REAVIS

Improvement Permit by: STEVE HEDRICK date 11-1-02 Operation Permit by STEVE HEDRICK date 11-8-02

Authorization to Construct by: STEVE HEDRICK date 11-1-02 Existing System Inspection by date

HEALTH DEPT COPY WHITE OWNER COPY (FINAL) YELLOW OWNER COPY (INITIAL) PINK