IREDELL COUNTY HEALTH DEPARTMENT

STATESVILLE 704-878-5305 MOORESVILLE 704-664-5281

IMPROVEMENT PERMIT / AUTHORIZATION TO CONSTRUCT / OPERATION PERMIT / EXISTING SYSTEM INSPECTION

PERMIT# REPAIR PIN# 4860-56-6409

OWNER OR CONTRACTOR CARL WILLIAMS PHONE: Business Home 704-881-0224 DATE 6-25-03

ADDRESS 311 S. OAK ST, STATESVILLE NC 28677

LOCATION US 21 NORTH, TL TABOR ROAD, 1ST ON LEFT AT BOX #727

SUBDIVISION BLOCK / SECTION LOT LOT AREA 0.18 ACRE SITE CLASS PS DESIGN FLOW 240 L.T.A.R. EXISTING

Septic Tank: EXISTING Gallons: STB Date

Pump Tank: Gallons: PT Date

Pump Make: Model Serial No.

Nitrification Field: No Fields 1 Square Feet 300 Linear Feet 100

No Lines TWO Trench Width 36" Max Trench Bottom Depth 40" +/- Gravel Depth 24"

☐ New System ☑ Repair System Type: I (II) III, IV, V, VI

System Description:

Repair System Description: CONVENTIONAL, GRAVITY

Maintenance Agreement Required: ☐ Yes ☐ No

☑ House/Mod. Home No. Bedrooms 2

☐ Mobile Home No. Bathrooms 1

☐ Business No. Employees

☐ Other


☐ Slab ☐ Crawl Space ☐ Basement w/plumbing ☐ Basement wo/plumbing

Water Supply: ☐ Individual ☑ Public ☐ Community

Comments:/Conditions: INSTALL NEW DISTRIBUTION BOX IN EXISTING DRAINLINE AS SHOWN, AS SHALLOW AS POSSIBLE, FEEDING TWO NEW DRAINLINES USING 24 INCHES STONE.

Comments:/Conditions: THIS PERMIT SERVES AS "NOTICE OF VIOLATION" SYSTEM TO BE REPAIRED BY 7-25-03.

INITIAL SITE SKETCH

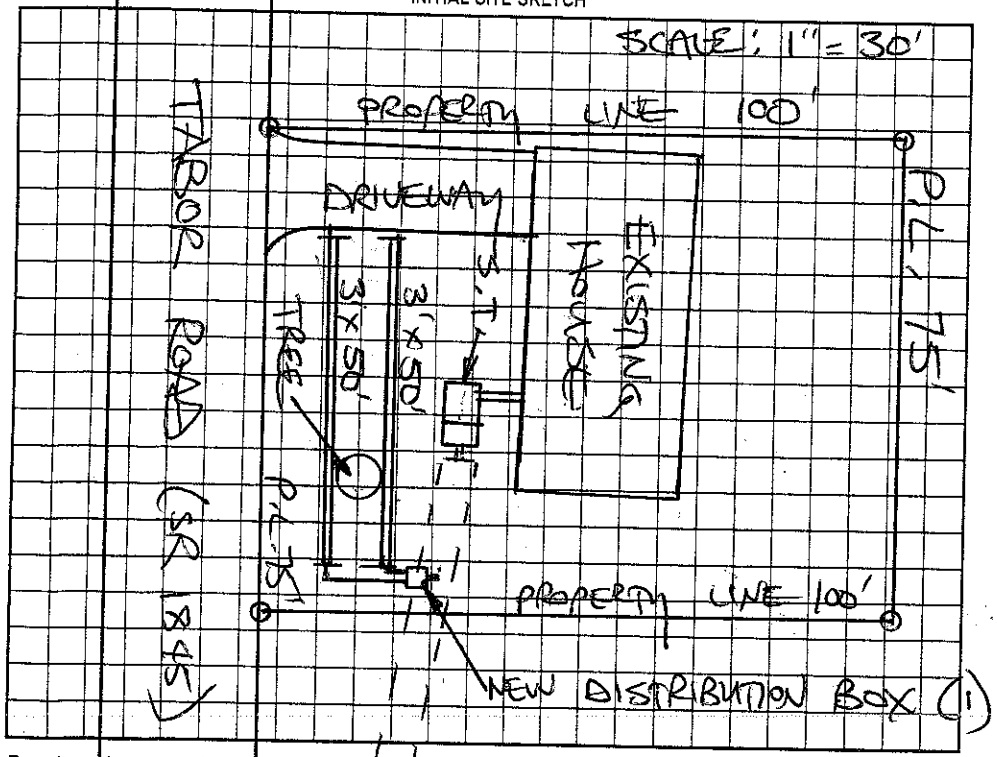

AS BUILT SKETCH

SYSTEM REPAIRED ACCORDING TO INITIAL SITE SKETCH

Permit can be suspended or revoked if any false information is supplied toward securing the permit/any unauthorized changes are made to the site/any unauthorized changes are made in the installation of the system. Improvement Permit with plat valid without expiration. Improvement Permit with site plan valid for sixty months. Authorization to Construct is valid for a period equal to that of Improvement Permit – not to exceed sixty months.

Signed: _____ date 6-25-03

Improvement Permit by: STEVE HENDRICK date 6-25-03

Authorization to Construct by: STEVE HENDRICK date 6-25-03

Installed by: IREDELL BACKHOE

Operation Permit by: STEVE HENDRICK date 8-16-04

Existing System Inspection by: _____ date _____

HEALTH DEPT. COPY: WHITE OWNER COPY (FINAL): YELLOW OWNER COPY (INITIAL): PINK