IREDELL COUNTY HEALTH DEPARTMENT

STATESVILLE 704-878-5305 MOORESVILLE 704-664-5281

IMPROVEMENT PERMIT / CERTIFICATE OF COMPLETION / OPERATION PERMIT / EXISTING SYSTEM INSPECTION

PROPERTY DESCRIPTION NO. 070161 DATE 10-30-97 TAX MAP NO. 4860 48 8965 Watershed: ☐ Yes ☒ No

OWNER OR CONTRACTOR JOHN C. DEPEW PHONE: Business Home 876-6036

ADDRESS 347 TATUM ROAD, OLIN, NC 28660

LOCATION US 21 N, TL TABOR ROAD, TL TATUM ROAD, 1ST DRIVE ON LEFT

SUBDIVISION BLOCK / SECTION LOT LOT AREA 3.29 ACRES SITE CLASS. PS DESIGN FLOW 360 L.T.A.R. 0.30 GPD/FT²

Septic Tank: 1000 Gallons; STB 1012 Date 2-27-98

Pump Tank: Gallons; PT Date

Pump Make: Model Serial No.

Nitrification Field: No Fields 1 Square Feet 1200 Linear Feet 400

No Lines FOUR Trench Width 36" Max Trench Bottom Depth 36" Gravel Depth 12"

☒ New System ☐ Repair System Type: I, II, III, IV, V, VI

System Description: CONVENTIONAL GRAVITY

Repair System Description: CONV. GRAVITY

Maintenance Agreement Required: ☐ Yes ☒ No

☒ House/Mod. Home No. Bedrooms 3

☐ Mobile Home No. Bathrooms 2

☐ Business No. Employees

☐ Other


☐ Slab ☒ Crawl Space ☐ Basement w/plumbing ☐ Basement wo/plumbing

Water Supply: ☒ Individual ☐ Community ☐ Public WELL

Comments: SCOUR TRENCH SIDEWALLS WHERE SMEARING OCCURS

Comments:

INITIAL SITE SKETCH SCALE: 1" = 50'

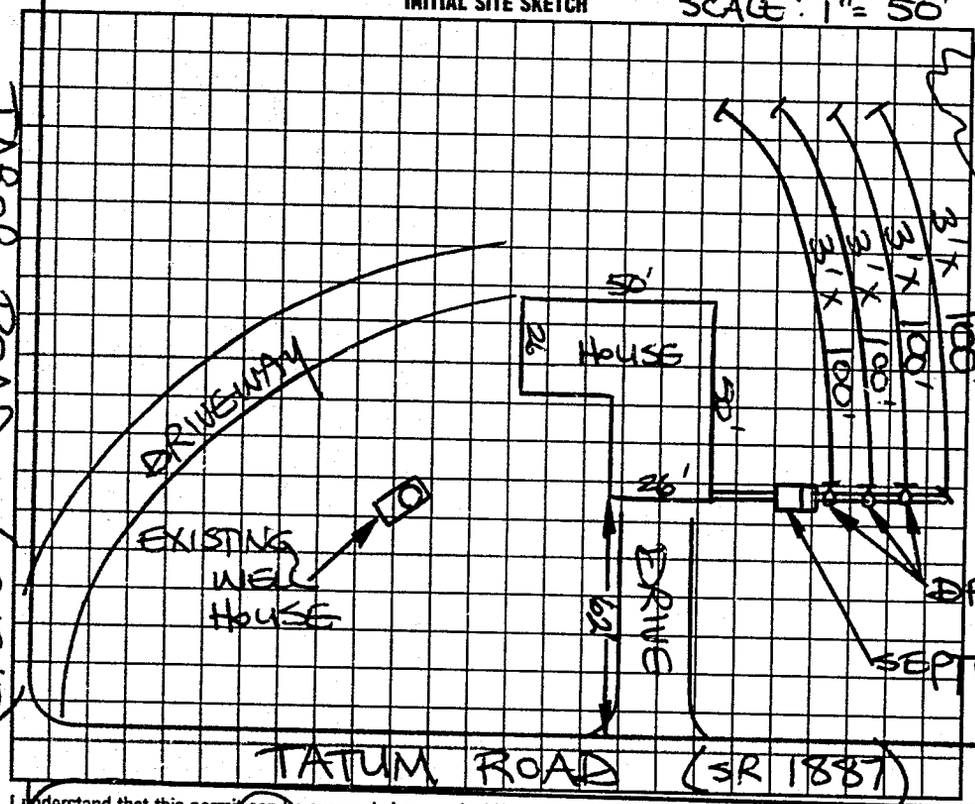

AS BUILT SKETCH

Installed as shown

I understand that this permit can be suspended or revoked if any false information is supplied toward securing the permit/any unauthorized changes are made to the site/any unauthorized changes are made in the installation of the system. Improvement Permit is valid for 60 months from date of issuance. AUTHORIZATION TO CONSTRUCT IS VALID FOR 60 MONTHS FROM DATE OF ISSUANCE.

Signed: X J. C. DePew

Improvement Permit by: STEVE HEDRICK date 10-30-97

AUTH. TO CONST. Existing System Inspection by: STEVE HEDRICK date 10-30-97

Installed by: Kenny Madison

~~Certificate of Completion by:~~ date

Operation Permit by: RS date 4-27-98

HEALTH DEPT. COPY: WHITE INSPECTION COPY (FINAL): GREEN OWNER COPY (FINAL): YELLOW INSPECTION COPY (INITIAL): PINK OWNER COPY (INITIAL): GOLD