IREDELL COUNTY HEALTH DEPARTMENT

STATESVILLE 704-878-5305 (R1) MOORESVILLE 704-664-5281

IMPROVEMENT PERMIT / AUTHORIZATION TO CONSTRUCT / OPERATION PERMIT / EXISTING SYSTEM INSPECTION

PERMIT# 112027 PIN# 4860-60-5787 DATE 4-22-03

OWNER OR CONTRACTOR MAX R. JAMES PHONE: Business Home (704) 546-2551

ADDRESS 450 TABOR RD. OLIN NC 28660

LOCATION US 21 NORTH, TL TABOR ROAD, 1ST HOUSE ON RIGHT PAST TOMLIN MILL ROAD,

SUBDIVISION BLOCK / SECTION LOT LOT AREA 5 ACRES SITE CLASS. PS DESIGN FLOW 100 L.T.A.R. 0.30 GPD/FT²

Septic Tank: ~~1000~~ 1500 Gallons; STB 338 Date

Pump Tank: ~~1500~~ Gallons; PT Date

Pump Make: ATLANTIC Model Serial No.

Nitrification Field: No Fields ☑ Square Feet 450 Linear Feet 150

No Lines TWO Trench Width 36" Max Trench Bottom Depth 36" Gravel Depth 12"

☑ New System ☐ Repair System Type: I. II. III. IV. V. VI

System Description: CONVENTIONAL GRAVITY

Repair System Description: CONVENTIONAL GRAVITY

Maintenance Agreement Required: ☐ Yes ☑ No

☐ House/Mod. Home No. Bedrooms

☐ Mobile Home No. Bathrooms

☐ Business No. Employees 1

☑ Other BARN


☑ Slab ☐ Crawl Space ☐ Basement w/plumbing ☐ Basement wo/plumbing

Water Supply: ☐ Individual ☑ Public ☐ Community


Comments:/Conditions:

Comments:/Conditions: SEPTIC TANK WITH MARKER INSTALLED USING "ZABEL" FILTER

INITIAL SITE SKETCH

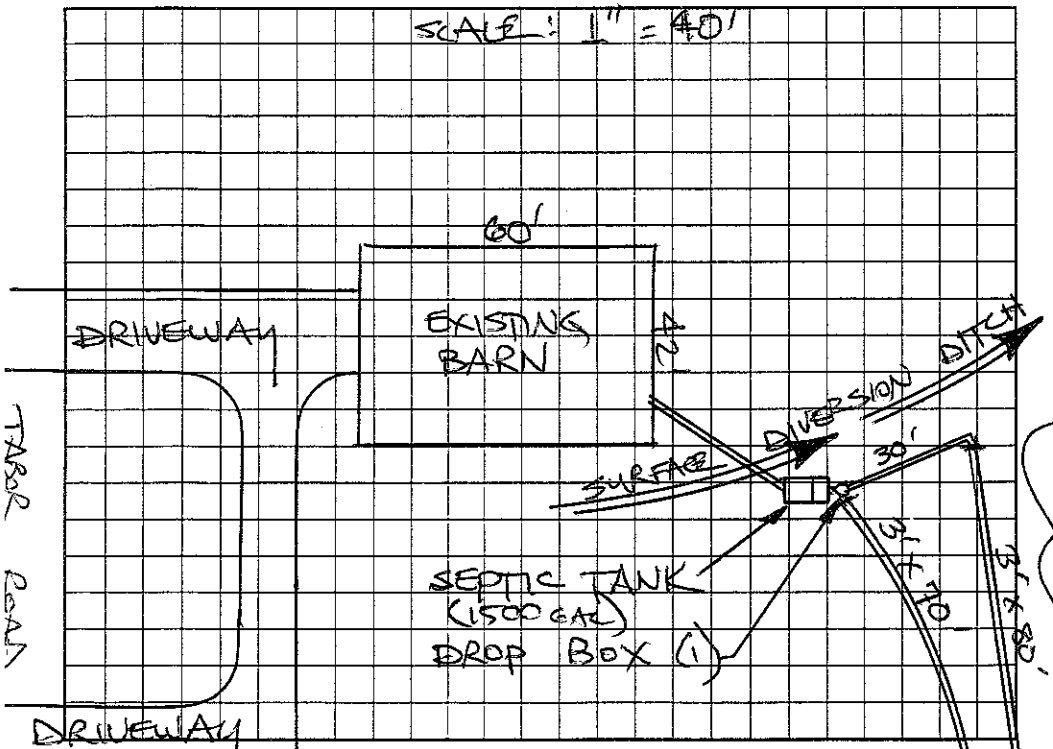

AS BUILT SKETCH

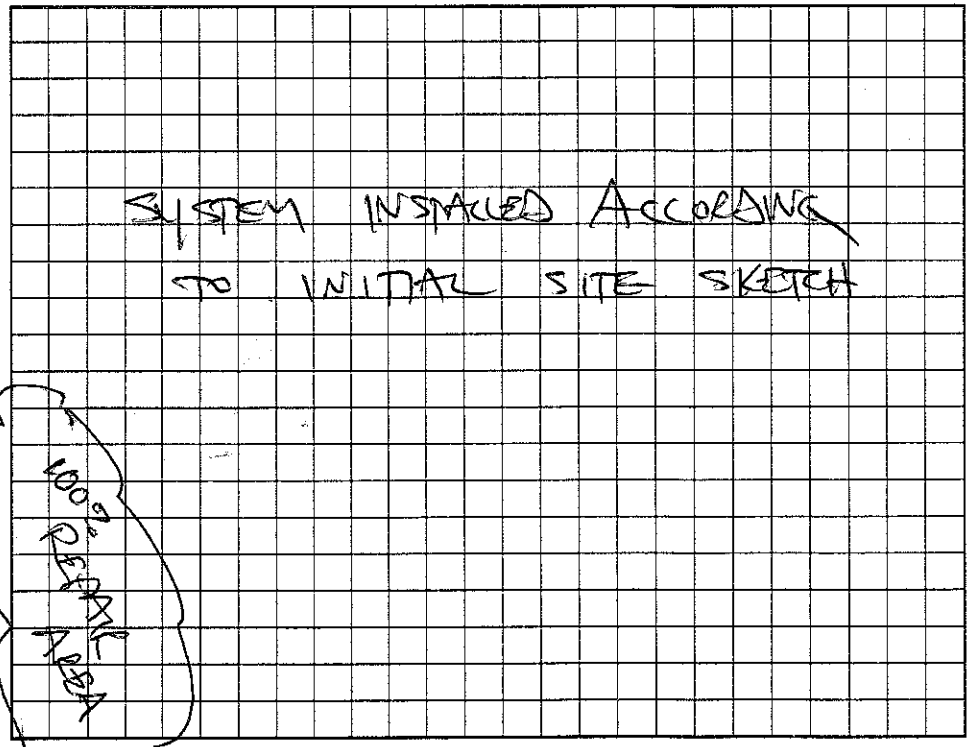

Permit can be suspended or revoked if any false information is supplied toward securing the permit/any unauthorized changes are made to the site/any unauthorized changes are made in the installation of the system. Improvement Permit with plat valid without expiration. Improvement Permit with site plan valid for sixty months. Authorization to Construct is valid for a period equal to that of Improvement Permit – not to exceed sixty months.

Signed: Max R James date 4/22/03 Installed by: BRENT GALLIHER

Improvement Permit by: STEVE HENDRICK date 4-22-03 Operation Permit by: STEVE HENDRICK date 5-15-03

Authorization to Construct by: STEVE HENDRICK date 4-22-03 Existing System Inspection by: date

HEALTH DEPT. COPY: WHITE OWNER COPY (FINAL): YELLOW OWNER COPY (INITIAL): PINK