IREDELL COUNTY HEALTH DEPARTMENT

STATESVILLE 704-878-5305 MOORESVILLE 704-664-5281

IMPROVEMENT PERMIT / AUTHORIZATION TO CONSTRUCT / OPERATION PERMIT / EXISTING SYSTEM INSPECTION

PERMIT # Repair PIN # 4860-61-4952 DATE 26 May 10

OWNER or APPLICANT Isadore James PHONE: Business (704) 546-2362 Home:

OWNER or APPLICANT ADDRESS 520 Tabor Rd. Olin, NC

LOCATION / DIRECTIONS 2 IN Tabor Rd. 2 miles on Rt. #510 Tabor Rd - Olin

SUBDIVISION BLOCK / SECTION LOT # LOT AREA 0.5 Ac. DESIGN FLOW 240 gpd L.T.A.R. 0.3 gpd/ft²

Septic Tank Exist. Gallons: STB Date

Pump Tank Gallons: P T Date

Pump Make Model Serial #

Nitrification Field No Fields 1 No Lines 3 Linear Feet 200

Trench Width 36" Max. Trench Bottom Depth 36" Gravel Depth NA

☐ New System ☑ Repair ☐ Expansion System Type I II (III) IV V VI

System Description: 25% Reduction System

Repair System Description:

Maintenance Agreement Required ☐ YES ☑ NO

☑ GRAVITY ☐ PRESSURE

☑ Residence No. Bedrooms 2

☐ Business No. Persons

☐ Other No. Employees

☐ Slab ☐ Crawl Space


☐ Basement w/plumbing ☑ Basement w/o plumbing

Water Supply: ☑ Private ☐ Public ☐ Community

Comments / Conditions: Follow contour / Add Drop-box to exist. system and Keep connected to new system.

Comments / Conditions

INITIAL SITE SKETCH

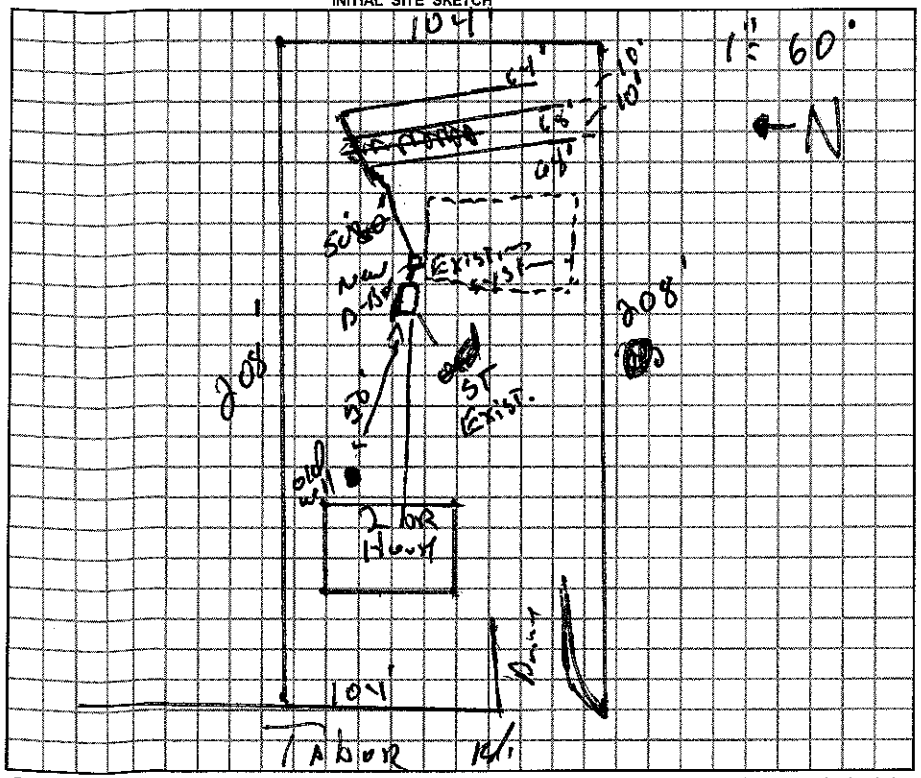

AS BUILT SKETCH

Installed as drawn.

Permit can be suspended or revoked if any false information is supplied toward securing the permit / any unauthorized changes are made to the site / any unauthorized changes are made in the installation of the system.

☐ *IMPROVEMENT PERMIT w / plat valid without expiration* ☐ *IMPROVEMENT PERMIT w / site plan valid for 60 mos.* ☑ *AUTHORIZATION TO CONSTRUCT valid for period equal to IMPROVEMENT PERMIT-not to exceed 60 mo.*

Applicant Signature: Isadore James Date 6-22-10

by: Date

Construct by: [signature], R.S. Date 28 May 10

Installed by: Steve Jordan

Operation Permit by: [signature], R.S. Date: 19 July 10

Existing System Inspected by: Date:

CALL CONTACT A LOCATOR SERVICE PRIOR TO ANY EXCAVATION.

WHITE COPY Environmental Health YELLOW COPY (Final) Owner / Applicant PINK COPY (Initial) Owner / Applicant