IREDELL COUNTY HEALTH DEPARTMENT

STATESVILLE 704-878-5305 MOORESVILLE 704-664-5281

IMPROVEMENT PERMIT / AUTHORIZATION TO CONSTRUCT / OPERATION PERMIT / EXISTING SYSTEM INSPECTION

PERMIT# 084251 PIN# 4860 61 6730 DATE 10-26-99

OWNER OR CONTRACTOR CRYSTAL GAITHER PHONE: Business Home 546-7149

ADDRESS P.O. BOX 5, TURNERSBURG, NC 28688

LOCATION US 21 NORTH, TL TABOR ROAD, 1.5 MILES ON RIGHT BEHIND BOX # 498

SUBDIVISION BLOCK / SECTION LOT LOT AREA 0.53 ACRE SITE CLASS PS DESIGN FLOW 360 L.T.A.R. EXISTING

Septic Tank: 1000 Gallons; STB 825 Date 11-6-99
Pump Tank: Gallons; PT Date
Pump Make: Model Serial No.
Nitrification Field: No Fields 1 Square Feet Linear Feet EXISTING
No Lines Trench Width Max Trench Bottom Depth

☒ New System ☐ Repair System Type: I II III IV V VI
System Description: CONVENTIONAL GRAVITY
Repair System Description: 50% REDUCTION GRAVITY
Maintenance Agreement Required: ☐ Yes ☒ No
Gravel Depth ☐ Slab ☑ Crawl Space ☐ Basement w/plumbing ☐ Basement wo/plumbing


☑ House/Mod Home No. Bedrooms 3
☑ Mobile Home No. Bathrooms 2
☐ Business No. Employees
☐ Other

Water Supply: ☐ Individual ☐ Public ☐ Community


Comments/Conditions ① REPLACE EXISTING SEPTIC TANK WITH NEW 1000 GALLON PRECAST SEPTIC TANK W/ RISERS ② CRUSH EXISTING SEPTIC TANK & FILL WITH DIRT.

Comments/Conditions NO PERMIT WAS FOUND FOR EXISTING SEPTIC SYSTEM. EXISTING SYSTEM UNDERSIZED USING TODAYS STANDARDS.

INITIAL SITE SKETCH

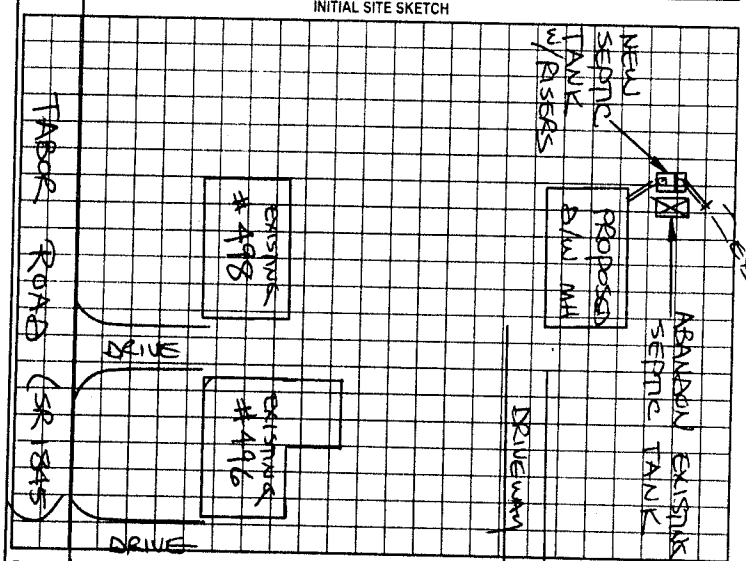

AS BUILT SKETCH

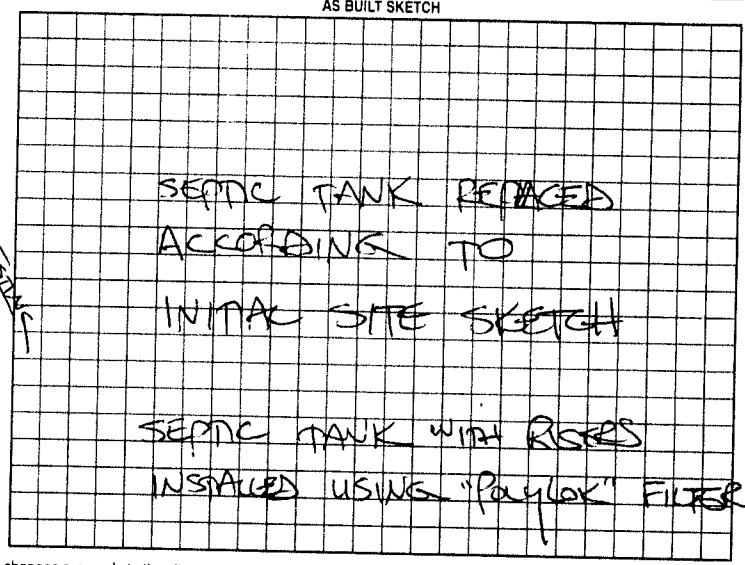

Permit can be suspended or revoked if any false information is supplied toward securing the permit/any unauthorized changes are made to the site/any unauthorized changes are made in the installation of the system. Improvement Permit with plat valid without expiration. Improvement Permit with site plan valid for sixty months. Authorization to Construct is valid for a period equal to that of Improvement Permit – not to exceed sixty months.

Signed: Crystal M. Gaither date

Improvement Permit by: STEVE HEARICK date 10.26.99

Authorization to Construct by: STEVE HEARICK date 10-26-99

Installed by: C & W GRADING

Operation Permit by: STEVE HEARICK date 1-7-00

Existing System Inspection by: date

HEALTH DEPT COPY WHITE OWNER COPY (FINAL) YELLOW OWNER COPY (INITIAL) PINK