IREDELL COUNTY HEALTH DEPARTMENT

STATESVILLE 704-878-5305 MOORESVILLE 704-664-5281 5/19 2

IMPROVEMENT PERMIT / CERTIFICATE OF COMPLETION / OPERATION PERMIT / EXISTING SYSTEM INSPECTION

PROPERTY DESCRIPTION NO. 18423 DATE 5/5/94 TAX MAP NO. 12P-A-51A Watershed: ☐ Yes ☑ No

OWNER OR CONTRACTOR FRED CHAPMAN, SR PHONE: Business _____ Home 873-2172

ADDRESS RT. 1, BOX 88, OLIN, NC 28660

LOCATION US 21 N, TL TABOR ROAD, ~ 1.7 MILE ON (L) BACK IN WOODED AREA

SUBDIVISION _____ BLOCK / SECTION _____ LOT _____ LOT AREA 26 AC SITE CLASS. PS DESIGN FLOW 360 L.T.A.R. EXISTING

Septic Tank: 1000 Gallons; STB _____ Date _____

Pump Tank: _____ Gallons; PT _____ Date _____

Pump Make: _____ Model _____ Serial No. _____

Nitrification Field: No Fields 1 Square Feet 750 Linear Feet 250

No Lines 2 Trench Width _____ Max Trench Bottom Depth _____ Gravel Depth 12"

☐ New System ☐ Repair System Type: (I) II, III, IV, V, VI

System Description: CONV. GRAVITY

Repair System Description: _____

Maintenance Agreement Required: ☐ Yes ☑ No

☐ Slab ☑ Crawl Space ☐ Basement w/plumbing ☐ Basement wo/plumbing

☐ House/Mod. Home No. Bedrooms 3

☑ Mobile Home No. Bathrooms 2

☐ Business No. Employees _____


☐ Other _____

Water Supply:
☑ Individual
☐ Community
☐ Public
WELL


Comments:

Comments: ① REMOVE EXISTING S/W MH FROM SYSTEM
② KEEP ALL VEHICULAR TRAFFIC OFF SYSTEM.

INITIAL SITE SKETCH

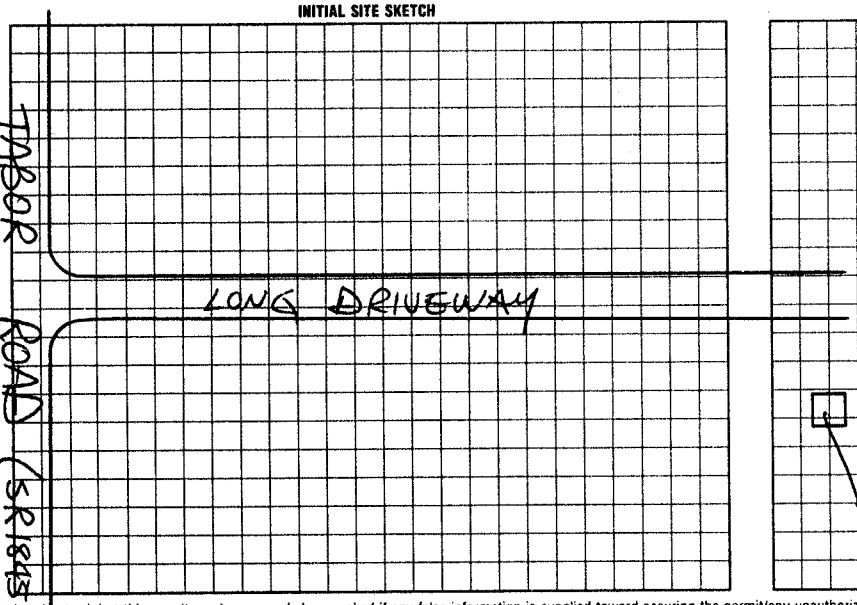

AS BUILT SKETCH

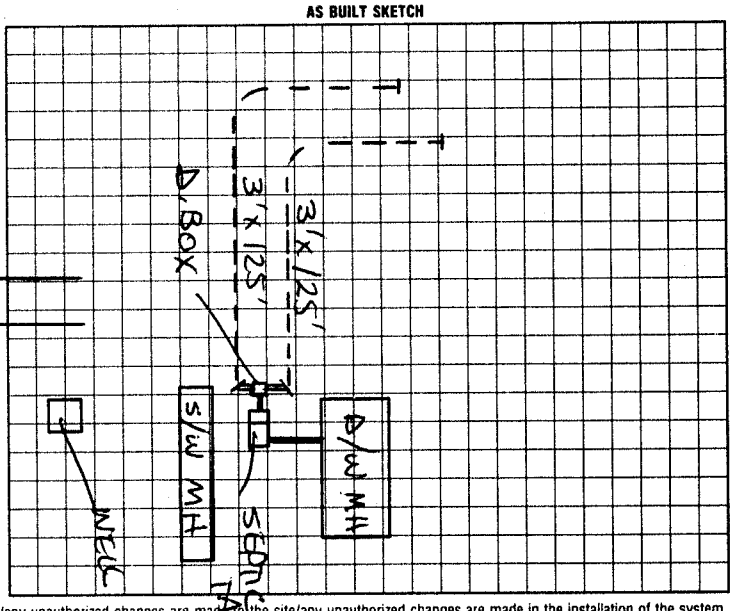

I understand that this permit can be suspended or revoked if any false information is supplied toward securing the permit/any unauthorized changes are made to the site/any unauthorized changes are made in the installation of the system. Improvement Permit is valid for 60 months from date of issuance.

Signed: _____ Installed by: _____

Improvement Permit by: _____ date _____ Certificate of Completion by: _____ date _____

Existing System Inspection by: STEVE HEARICK date 5/5/94 Operation Permit by: _____ date _____

HEALTH DEPT. COPY: WHITE INSPECTION COPY (FINAL): GREEN OWNER COPY (FINAL): YELLOW INSPECTION COPY (INITIAL): PINK OWNER COPY (INITIAL): GOLD