Repair

IREDELL COUNTY HEALTH DEPARTMENT

STATESVILLE 704-878-5305 MOORESVILLE 704-664-5281

IMPROVEMENT PERMIT / AUTHORIZATION TO CONSTRUCT / OPERATION PERMIT / EXISTING SYSTEM INSPECTION

PERMIT # Repair PIN # 4860-62-4056 DATE 22 March 10

OWNER or APPLICANT Isadore James PHONE: Business Home: (704) 546-2362

OWNER or APPLICANT ADDRESS 520 Tabor Rd. Olin N.C.

LOCATION / DIRECTIONS 21 N TL Tabor Rd 1.5 mile on Rt. #520 Tabor Rd - Olin

SUBDIVISION BLOCK / SECTION LOT # LOT AREA 1Ac DESIGN FLOW 240 gpd L.T.A.R. 0.3 gpd/ft²

Septic Tank Exist. Gallons: STB Date

Pump Tank Gallons: P T Date

Pump Make Model Serial #

Nitrification Field No Fields 1 No Lines 2 Linear Feet 200

Trench Width 36" Max. Trench Bottom Depth 36" Gravel Depth N/A

☐ New System ☑ Repair ☐ Expansion System Type I II (III) IV V VI

System Description:

Repair System Description: 25% Reduction

Maintenance Agreement Required ☐ YES ☑ NO

☑ GRAVITY ☐ PRESSURE

☑ Residence No. Bedrooms 2

☐ Business No. Persons

☐ Other No. Employees

☐ Slab ☑ Crawl Space


☐ Basement w/plumbing ☐ Basement w/o plumbing

Water Supply: ☐ Private ☑ Public ☐ Community


Comments / Conditions: Replace tee with filter tee / Follow contour w/ system. / Keep out of power-line R/w-of-way / Have all setbacks.

Comments / Conditions: * Existing tee is OK. and was not replaced.

INITIAL SITE SKETCH

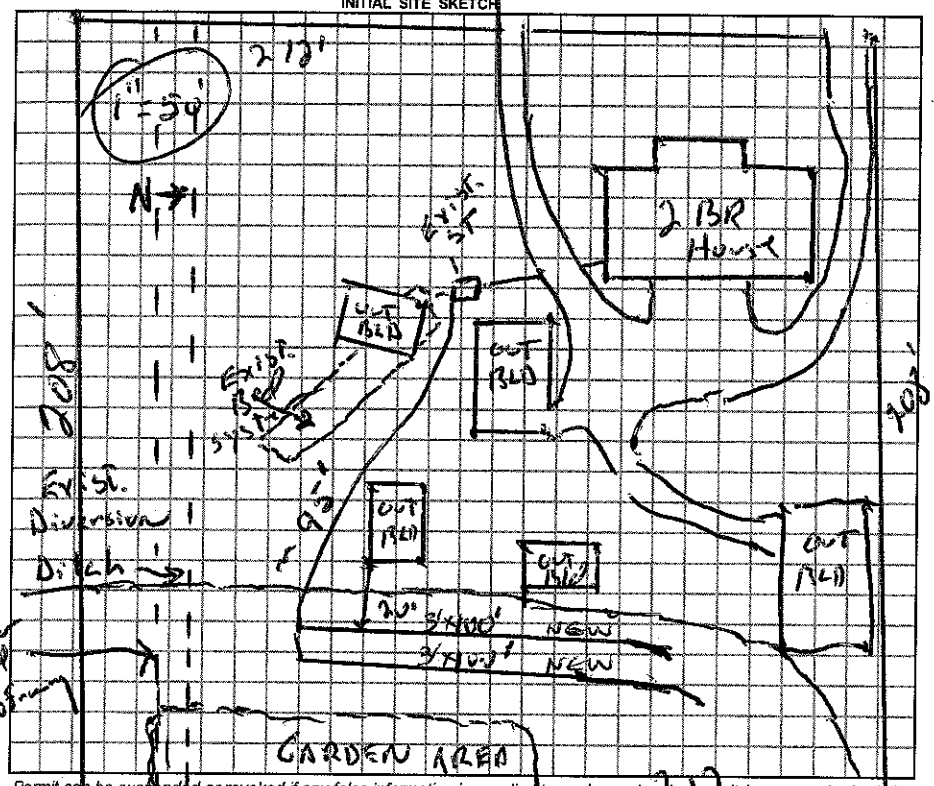

AS BUILT SKETCH

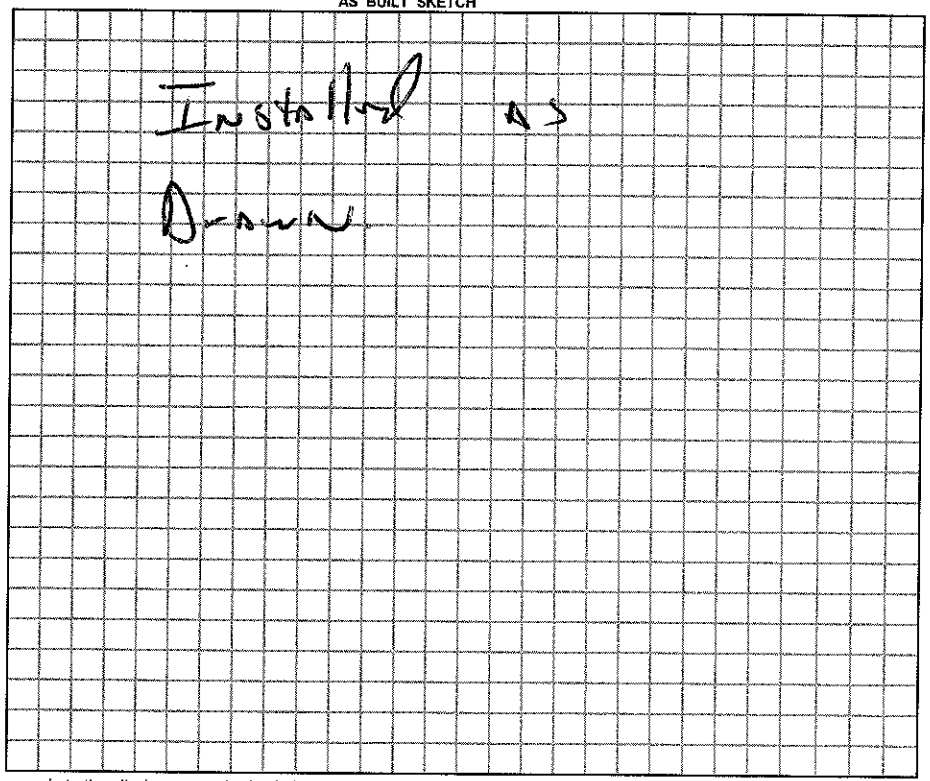

Permit can be suspended or revoked if any false information is supplied toward securing the permit / any unauthorized changes are made to the site / any unauthorized changes are made in the installation of the system.

☐ *IMPROVEMENT PERMIT w/ plat valid without expiration.* ☐ *IMPROVEMENT PERMIT w / site plan valid for 60 mos.* ☑ *AUTHORIZATION TO CONSTRUCT valid for period equal to IMPROVEMENT PERMIT-not to exceed 60 mo.*

Owner / Applicant Signature: Isadore James Date 3.23.10

Improvement Permit by: Date

Authorzation to Construct by: R.S. Date 22 March 10

Installed by: Steve Jordan

Operation Permit by: R.S. Date: 1 April 10

Existing System Inspected by: Date:

YOU SHOULD CONTACT A LOCATOR SERVICE PRIOR TO ANY EXCAVATION.

WHITE COPY Environmental Health YELLOW COPY (Final) Owner / Applicant PINK COPY (Initial) Owner / Applicant