IREDELL COUNTY HEALTH DEPARTMENT

STATESVILLE 704-878-5305 MOORESVILLE 704-664-5281

IMPROVEMENT PERMIT / AUTHORIZATION TO CONSTRUCT / OPERATION PERMIT / EXISTING SYSTEM INSPECTION

PERMIT# 071365 PIN# 4860628292

OWNER OR CONTRACTOR Mark Gaither DATE 2-27-98

ADDRESS 126 Gatton Drive, Harmony PHONE: Business Home

LOCATION 21N TL Tabor TL2 Gatton bear (R) at First Drive 2nd lot.

SUBDIVISION BLOCK / SECTION LOT LOT AREA SITE CLASS. DESIGN FLOW 360 L.T.A.R. 0.3

Septic Tank: 1000 Gallons; STB 1012 Date 1-5-98

Pump Tank: Gallons; PT Date

Pump Make: Model Serial No.

Nitrification Field: No Fields 1 Square Feet 900 Linear Feet 300

No Lines 6 Trench Width 36 Max Trench Bottom Depth 36 ~~Gravel Depth~~ Sand

[X] New System ☐ Repair System Type: I, II, III, IV, V, VI

System Description: Gravity Chamber

Repair System Description:

Maintenance Agreement Required: ☐ Yes ☐ No

☐ House/Mod. Home No. Bedrooms 3

[X] Mobile Home No. Bathrooms 2

☐ Business No. Employees

☐ Other


☐ Slab ☐ Crawl Space ☐ Basement w/plumbing ☐ Basement wo/plumbing

Water Supply: [X] Individual ☐ Public ☐ Community


Comments:/Conditions: keep lines on contour connect end to end keep five feet from property line, five feet from footers. Fill, Old Tank in back. ↑Pump out.

Comments:/Conditions:

INITIAL SITE SKETCH

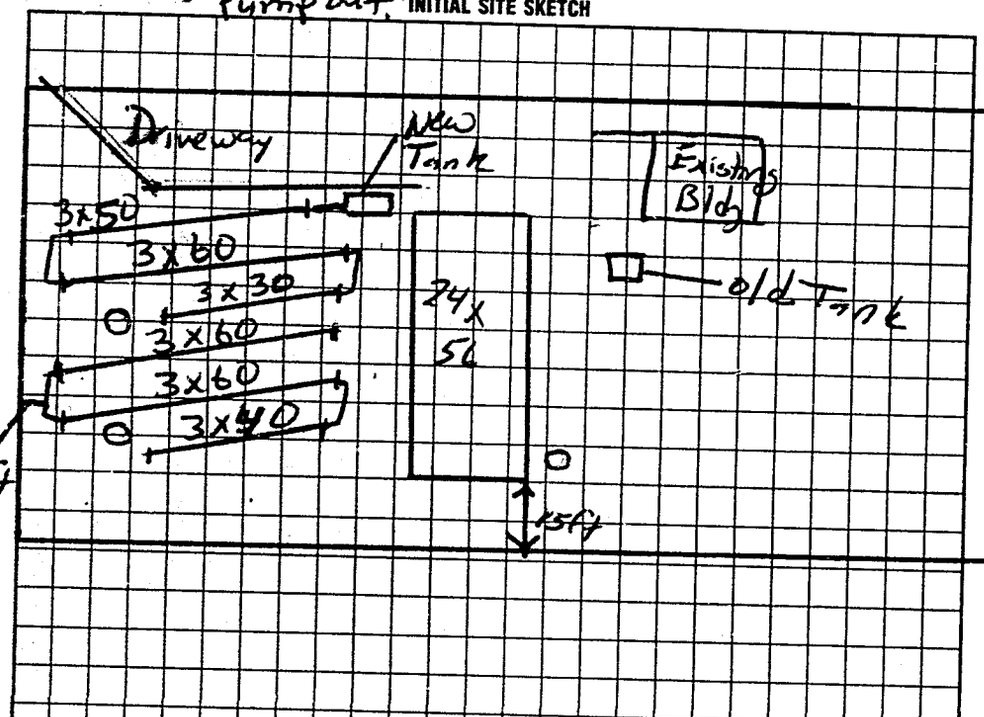

AS BUILT SKETCH

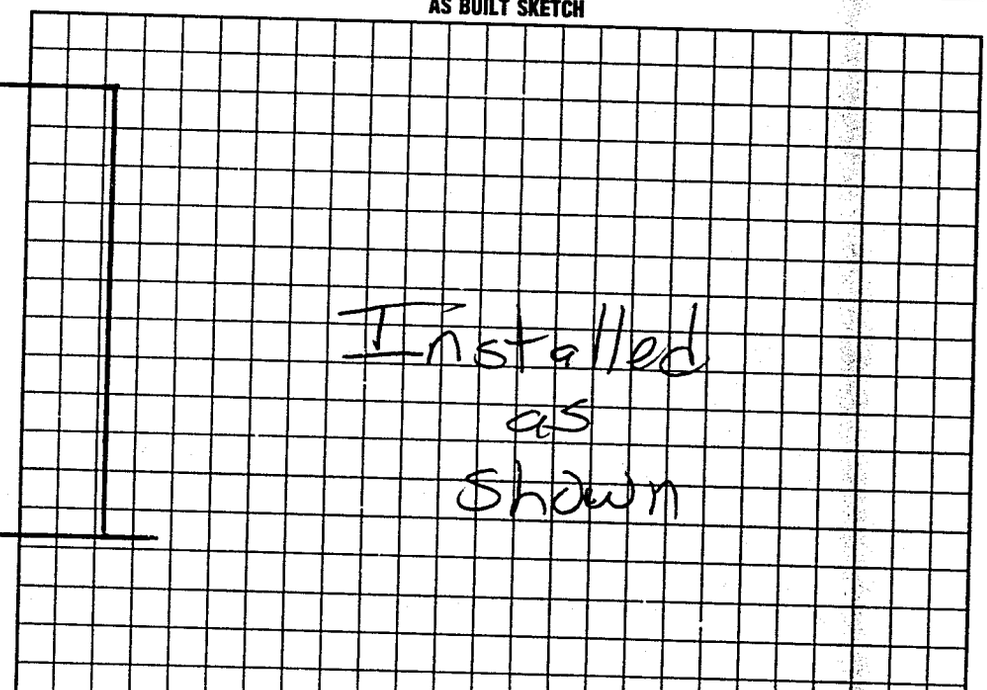

I understand that this permit can be suspended or revoked if any false information is supplied toward securing the permit/any unauthorized changes are made to the site/any unauthorized changes are made in the installation of the system. Improvement Permit with plat valid without expiration. Improvement Permit with site plan valid for sixty months. Authorization to Construct is valid for a period equal to that of Improvement Permit – not to exceed sixty months.

Signed: Dean A. Honeycutt

Improvement Permit by: Mark Cox RS date 2-27-98

Authorization to Construct by: Mark Cox RS date 2-27-98

Installed by: A-1 Backhoe

Operation Permit by: Mark Cox RS date 3-27-98

Existing System Inspection by: date

HEALTH DEPT. COPY: WHITE INSPECTION COPY (FINAL): GREEN OWNER COPY (FINAL): YELLOW INSPECTION COPY (INITIAL): PINK OWNER COPY (INITIAL): GOLD