9:30 - 10:00

IREDELL COUNTY HEALTH DEPARTMENT

STATESVILLE 704-878-5305 MOORESVILLE 704-664-5281

IMPROVEMENT PERMIT / AUTHORIZATION TO CONSTRUCT / OPERATION PERMIT / EXISTING SYSTEM INSPECTION

PERMIT# REPAIR PIN#

OWNER OR CONTRACTOR BILLY & SHARON TURNER PHONE: Business Home 546-2352 DATE 5-26-00

ADDRESS 124 TABOR ROAD, (GATION RD) OLIN, NC 28660

LOCATION US 21 North, TL TABOR ROAD, TR GATION DRIVE 1ST HOUSE ON RIGHT

SUBDIVISION BLOCK / SECTION LOT LOT AREA LIMITED SITE CLASS PS DESIGN FLOW L.T.A.R. EXISTING

Septic Tank: 1000 Gallons: STB 928 Date 5/16/00

Pump Tank: Gallons: PT Date

Pump Make: Model Serial No.

Nitrification Field: No Fields 1 Square Feet 900 Linear Feet 300

No Lines SIX Trench Width 36" Max Trench Bottom Depth 36" Gravel Depth 12"

☐ New System ☑ Repair System Type: I (II) III, IV, V, VI

System Description: CONVENTIONAL GRAVITY

Repair System Description: CONV. GRAVITY

Maintenance Agreement Required: ☐ Yes ☑ No

☑ House/Mod. Home No. Bedrooms

☐ Mobile Home No. Bathrooms

☐ Business No. Employees

☐ Other


☐ Slab ☑ Crawl Space ☐ Basement w/plumbing ☐ Basement wo/plumbing

Water Supply: ☐ Individual ☐ Public ☐ Community

Comments/Conditions: THIS PERMIT SERVES AS "NOTICE OF VIOLATION" - SYSTEM TO BE REPAIRED BY JUNE 30, 2000

Comments /Conditions:

INITIAL SITE SKETCH SCALE: 1" = 30'

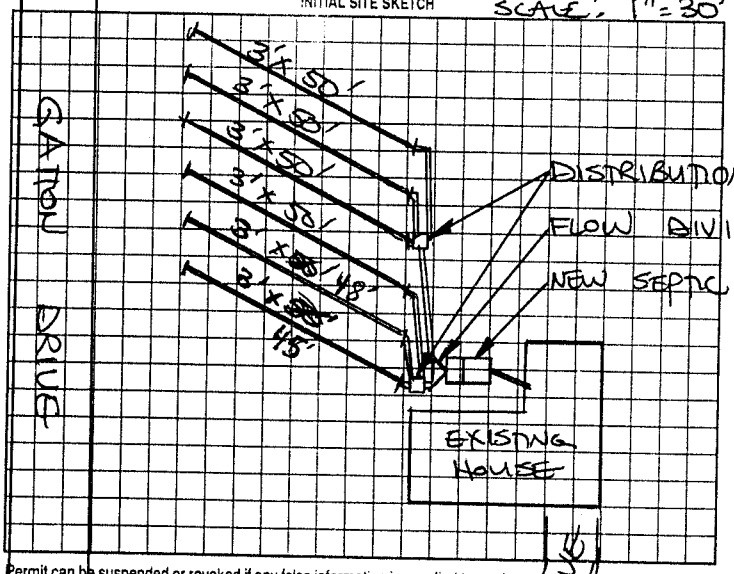

AS BUILT SKETCH

Permit can be suspended or revoked if any false information is supplied toward securing. The permit/any unauthorized changes are made to the site/any unauthorized changes are made in the installation of the system. Improvement Permit with plat valid without expiration. Improvement Permit with site plan valid for sixty months. Authorization to Construct is valid for a period equal to that of Improvement Permit – not to exceed sixty months.

Signed: Sharon Turner date 6-5-00 Installed by: Sammy Revis

Improvement Permit by: STEVE HENDRICK date 5-26-00 Operation Permit by: date 7/12/00

Authorization to Construct by: STEVE HENDRICK date 5-26-00 Existing System Inspection by: date

HEALTH DEPT. COPY: WHITE OWNER COPY (FINAL): YELLOW OWNER COPY (INITIAL): PINK