This permit replaces previous one issued 11-7-06

IREDELL COUNTY HEALTH DEPARTMENT

Statesville Office (704) 878-5305 Mooresville Office (704) 660-3625 PERMIT # 204359

IMPROVEMENT PERMIT / AUTHORIZATION TO CONSTRUCT / OPERATION PERMIT / EXISTING SYSTEM

PIN # 4860635155

APPLICANT: America's Home Place APPLICANT ADDRESS: 1206 Green Land Drive

PHONE: 704-677-2511 ALT. PHONE: N/A

SITE ADDRESS: 564 Taber Rd.

SITE DIRECTIONS: Hwy 21 N TL Taber Rd. Property on Left

SUBDIVISION: N/A SECTION: N/A LOT # N/A LOT AREA: 2.5 acres DESIGN FLOW: 360 gpd L.T.A.R.: 0.3

Septic Tank 1000 (gal) STB 760-1000 Date 3-11

Pump Tank (gal) PT Date

Pump Make Model Serial #

Nitrification Fields 1 # Lines 3 Linear Ft: 300

Trench Width 36" Max. Trench Bottom Depth 36" Gravel Depth N/A

☑ New System ☐ Repair ☐ Expansion System Type: I II (III) IV V VI

System Description: 25% Reduction

Repair System Description: 25% Reduction (pump)

Maintenance Agreement Required: ☐ YES ☑ NO

☑ GRAVITY ☐ PRESSURE

☑ Residence ☐ Business ☐ Other ☐ Slab ☑ Basement w/plumbing


No. Bedrooms 3 No. Persons 6 No. Employees

☐ Crawl Space ☐ Basement w/o plumbing

Water Supply: ☐ Private ☑ Public ☐ Community

Comments / Conditions: Install a 25% Reduction system on contour with serial distribution.

INITIAL SITE SKETCH

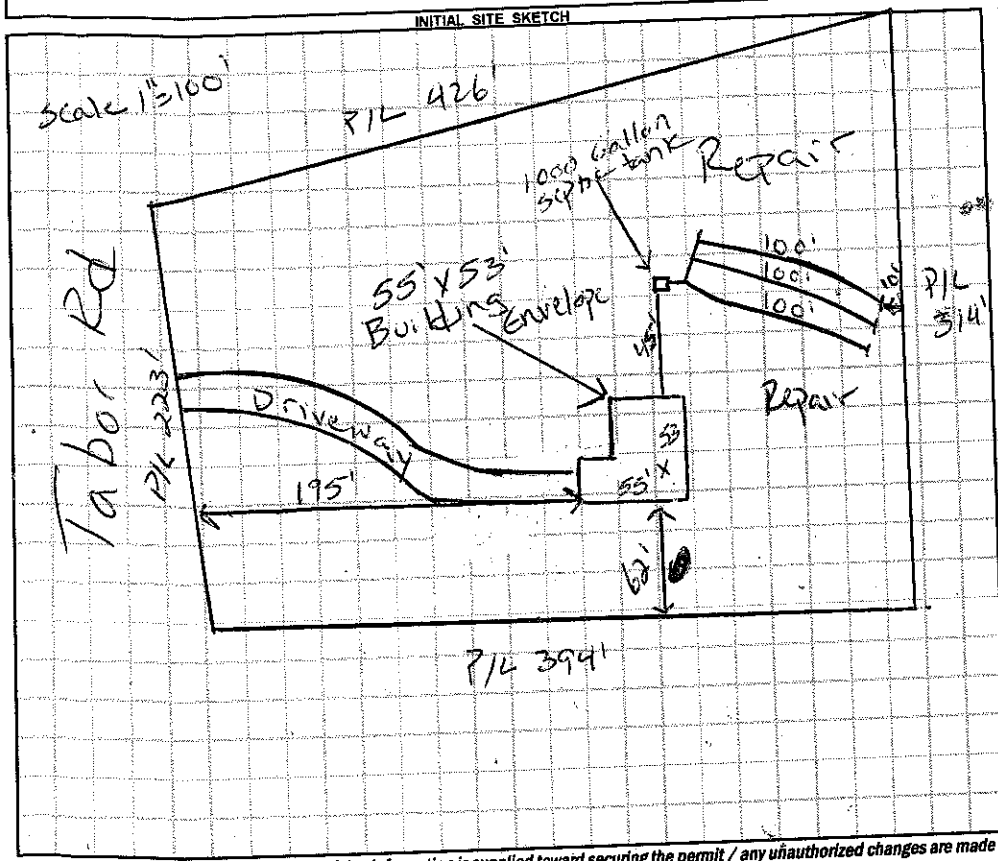

AS BUILT SKETCH

- Quick 4 Chambers installed
- Red Polylok filter installed
- Installed as drawn
- System installed before house was started

Permit can be suspended or revoked if any false information is supplied toward securing the permit / any unauthorized changes are made to the site / any unauthorized changes are made in the installation of the system. CONTACT A LOCATOR SERVICE PRIOR TO ANY EXCAVATION

☐ IMPROVEMENT PERMIT *with plat* valid without expiration. ☑ IMPROVEMENT PERMIT *with site plan* valid for 60 mos. ☑ AUTHORIZATION TO CONSTRUCT valid for period equal to IMPROVEMENT PERMIT--not to exceed 60 mo.

Owner / Applicant Signature: Wayne Horn Date: 7/11/14

IMPROVEMENT PERMIT by: Justin Henderson Date: 7-10-14

Justin Henderson Date: 7-10-14

Installed by: Groundbreakers

OPERATION PERMIT by: Justin Henderson Date: 7-18-14

Existing System Inspected by: Date:

Health Dept. Copy - WHITE Applicant (Final Approval) - YELLOW Applicant (Conditional Approval) - PINK