IREDELL COUNTY HEALTH DEPARTMENT

STATESVILLE 704-878-5305 MOORESVILLE 704-664-5281

IMPROVEMENT PERMIT / AUTHORIZATION TO CONSTRUCT / OPERATION PERMIT / EXISTING SYSTEM INSPECTION

PERMIT# 81132 PIN# 4860641991 DATE 5-19-99

OWNER OR CONTRACTOR Joby O'Shaughnessy PHONE: Business _____ Home 871 8799

ADDRESS 123 Family Cr.

LOCATION I-77 N TR Tomlin Mill TL Tabor 2 miles RT.

SUBDIVISION Holly Ridge BLOCK / SECTION 1 LOT 12 LOT AREA 2 acres SITE CLASS PS DESIGN FLOW 480 L.T.A.R. 1.39 gal/35' Hay

Septic Tank: 1000 Gallons; STB 1012 Date 7-8-99
Pump Tank: _____ Gallons; PT _____ Date _____
Pump Make: _____ Model _____ Serial No. _____
Nitrification Field: No Fields 1 Square Feet 1600 Linear Feet 533
No Lines 5 Trench Width 36" Max Trench Bottom Depth 36" Gravel Depth 12"


☒ New System ☐ Repair System Type: I II III IV V VI
System Description: Conv. Gravity
Repair System Description: " "
Maintenance Agreement Required: ☐ Yes ☒ No
☐ Slab ☒ Crawl Space ☐ Basement w/plumbing ☐ Basement wo/plumbing

☒ House/Mod. Home No. Bedrooms 4
☐ Mobile Home No. Bathrooms 2
☐ Business No. Employees _____
☐ Other _____

Water Supply: ☐ Individual ☒ Public ☐ Community


Comments/Conditions: 290'

INITIAL SITE SKETCH

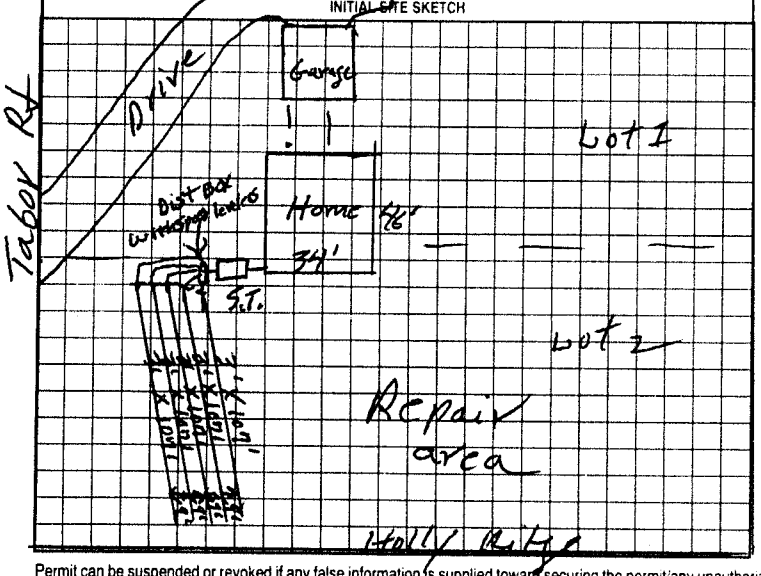

Comments/Conditions: 290'

AS BUILT SKETCH

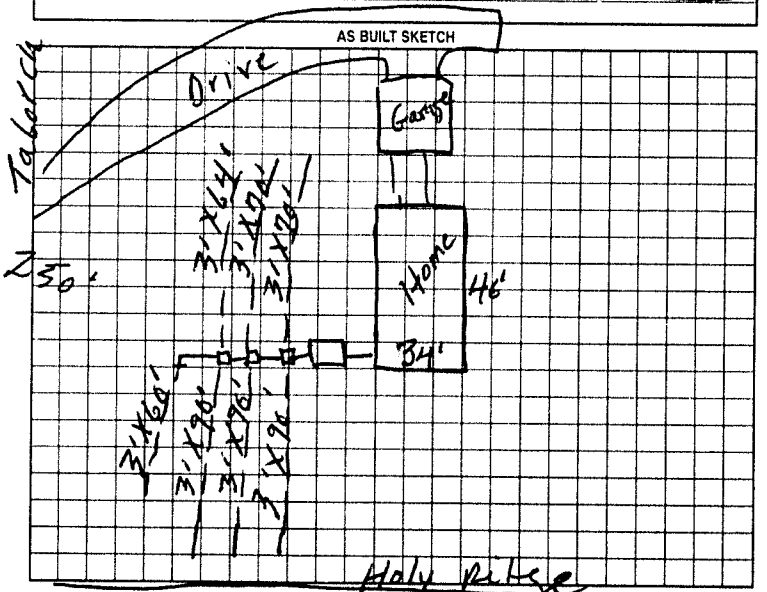

Permit can be suspended or revoked if any false information is supplied toward securing the permit/any unauthorized changes are made to the site/any unauthorized changes are made in the installation of the system. Improvement Permit with plat valid without expiration. Improvement Permit with site plan valid for sixty months. Authorization to Construct is valid for a period equal to that of Improvement Permit – not to exceed sixty months.

Signed: Joby O'Shaughnessy date 5/19/99 Installed by: C+W S.T.

Improvement Permit by: J. C. Moore date 5-19-99 Operation Permit by: J. C. Moore date 9-24-99

Authorization to Construct by: J. C. Moore date 5-19-99 Existing System Inspection by: _____ date _____

HEALTH DEPT. COPY WHITE OWNER COPY (FINAL) YELLOW OWNER COPY (INITIAL) PINK