THIS PERMIT VOIDS PREVIOUS ISSUED 11-13-2002

IREDELL COUNTY HEALTH DEPARTMENT

STATESVILLE 704-878-5305 CI MOORESVILLE 704-664-5281

IMPROVEMENT PERMIT / AUTHORIZATION TO CONSTRUCT / OPERATION PERMIT / EXISTING SYSTEM INSPECTION

PERMIT# 109285 PIN# 4860-64-2588 ← (2588) DATE 5-28-03

OWNER OR CONTRACTOR CECELIA K. CHAUNCEY PHONE: Business Home 704-546-2018

ADDRESS 636 TABOR ROAD, OLIN, NC 28660

LOCATION US 21 N TL TABOR RD, LOT ON RIGHT BETWEEN VALLEY SPRINGS & ASHFORD ROADS

SUBDIVISION HOLLY RIDGE BLOCK / SECTION 1 - (63) LOT ~~35 & 36~~ LOT AREA 1.85 ACRES SITE CLASS. PS DESIGN FLOW 480 L.T.A.R. 0.30 GPD/FT2

Septic Tank: 1000 Gallons; STB 1000 Date 5-12-03
Pump Tank: ____ Gallons; PT ____ Date ____
Pump Make: ____ Model ____ Serial No. ____
Nitrification Field: No Fields 1 Square Feet ~~2400~~ 1800 Linear Feet 400
No Lines FOUR Trench Width 36" Max Trench Bottom Depth 36" Gravel Depth N/A

☑ New System ☐ Repair System Type: I, II, III, IV, V, VI
System Description: 25% REDUCTION, GRAVITY
Repair System Description: 25% REDUCTION, GRAVITY
Maintenance Agreement Required: ☐ Yes ☑ No


☑ House/Mod. Home No. Bedrooms 4
☑ Mobile Home No. Bathrooms 2
☐ Business No. Employees ____
☐ Other ____
☐ Slab ☑ Crawl Space ☐ Basement w/plumbing ☐ Basement wo/plumbing

Water Supply: ☐ Individual ☑ Public ☐ Community


Comments:/Conditions: INSTALL 25% REDUCTION SYSTEM
PROPERTY LINE 388.88'

Comments:/Conditions: -poly lok filter, ST marker
-64 Infi/Hader Chambers Installed

INITIAL SITE SKETCH

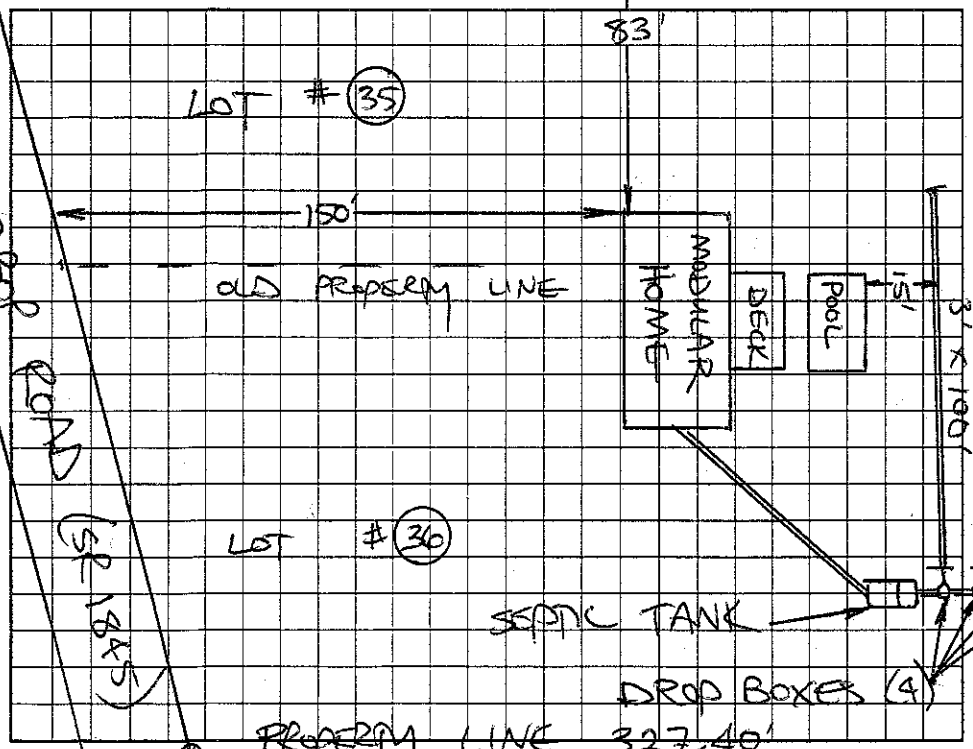

AS BUILT SKETCH

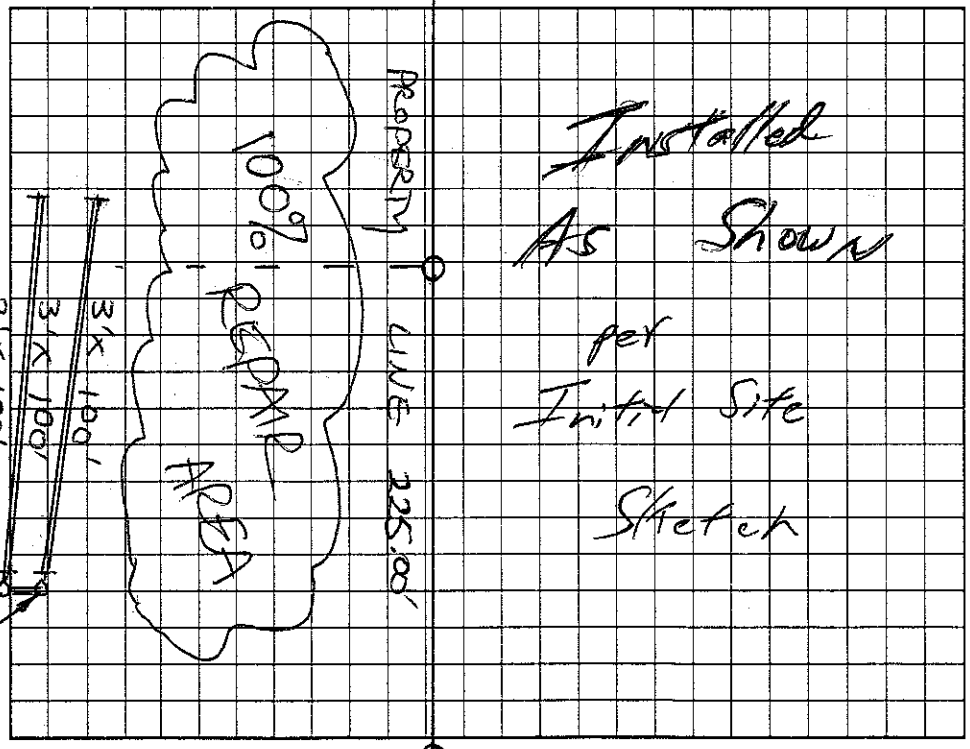

Permit can be suspended or revoked if any false information is supplied toward securing the permit/any unauthorized changes are made to the site/any unauthorized changes are made in the installation of the system. Improvement Permit with plat valid without expiration. Improvement Permit with site plan valid for sixty months. Authorization to Construct is valid for a period equal to that of Improvement Permit – not to exceed sixty months.

Signed: [signature] date 5/28/03 Installed by: Tommy Cothran & Son

Improvement Permit by: STEVE HENDRICK date 5-28-03 Operation Permit by: William Cothran date 7/7/03

Authorization to Construct by: STEVE HENDRICK date 5-28-03 Existing System Inspection by: ____ date ____

HEALTH DEPT. COPY: WHITE OWNER COPY (FINAL): YELLOW OWNER COPY (INITIAL): PINK