THIS PERMIT VOIDS PREVIOUS ISSUED 12-17-98

IREDELL COUNTY HEALTH DEPARTMENT

STATESVILLE 704-878-5305 MOORESVILLE 704-664-5281

IMPROVEMENT PERMIT / AUTHORIZATION TO CONSTRUCT / OPERATION PERMIT / EXISTING SYSTEM INSPECTION

PERMIT# 078150 PIN# 4860 64 3133 DATE 7-27-99

OWNER OR CONTRACTOR WILLIAM SHERRILL PHONE: Business Home 873-0111

ADDRESS 635 OAKDALE DRIVE, STATESVILLE, NC 28677

LOCATION US 21 North TL Tabor Road, Lot on Right, at Box # 614

SUBDIVISION Holly Ridge BLOCK / SECTION LOT 62 LOT AREA 1.13 ACRES SITE CLASS PS DESIGN FLOW 360 L.T.A.R. 0.30 GPD/FT²

Septic Tank: 1000 Gallons; STB 1012 Date 7-10-99
Pump Tank: Gallons; PT Date
Pump Make: Model Serial No.
Nitrification Field: No Fields 1 Square Feet Eq.T 1200 Linear Feet 300+
No Lines FOUR Trench Width 36" Max Trench Depth 36"

☑ New System ☐ Repair System Type: I, II, (III), IV, V, VI
System Description: 25% REDUCTION SYSTEM
Repair System Description: 25% REDUCTION SYSTEM
Maintenance Agreement Required: ☐ Yes ☑ No
Gravel Depth SAND 6"

☑ House/Mod. Home No. Bedrooms 3
☐ Mobile Home No. Bathrooms 2½
☐ Business No. Employees
☐ Other
Slab ☑ Crawl Space ☐ Basement w/plumbing ☐ Basement w/o plumbing


Water Supply: ☐ Individual ☑ Public ☐ Community

Comments/Conditions: INSTALL 25% REDUCTION SYSTEM USING FIFTY (50) CHAMBERS OR THIRTY (30) HDS SECTIONS

Comments/Conditions: SEPTIC TANK WITH RISERS INSTALLED USING TANK LOCATER AND "POLYLOK" FILTER

SCALE: 1" = 50'

INITIAL SITE SKETCH

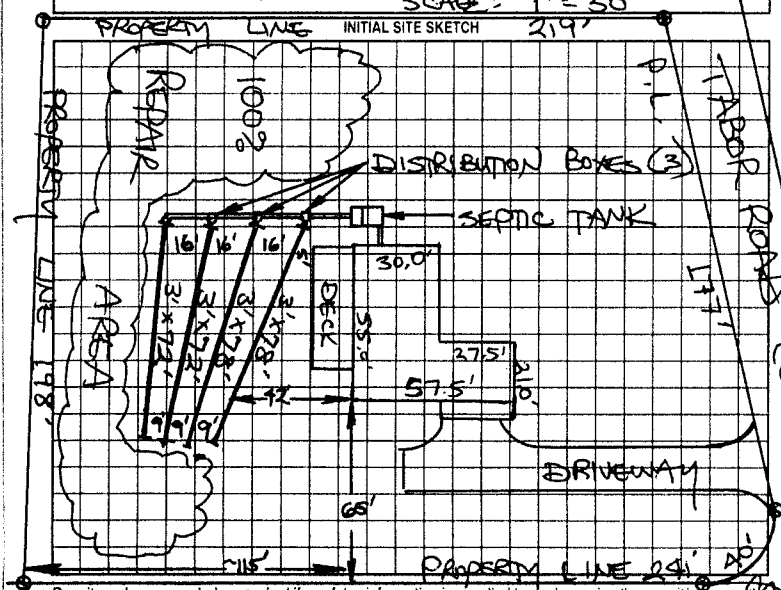

AS BUILT SKETCH

HDS SYSTEM INSTALLED ACCORDING TO INITAL SITE SKETCH

Permit can be suspended or revoked if any false information is supplied toward securing the permit/any unauthorized changes are made to the site/any unauthorized changes are made in the installation of the system. Improvement Permit with plat valid without expiration. Improvement Permit with site plan valid for sixty months. Authorization to Construct is valid for a period equal to that of Improvement Permit - not to exceed sixty months.

Signed: William K. Sherrill date 7/27/99 Installed by: A-1 BACKHOE

Improvement Permit by: STEVE HEDRICK date 7-27-99 Operation Permit by: STEVE HEDRICK date 9-23-99

Authorization to Construct by: STEVE HEDRICK date 7-27-99 Existing System Inspection by: date

HEALTH DEPT. COPY WHITE OWNER COPY (FINAL) YELLOW OWNER COPY (INITIAL) PINK