IREDELL COUNTY HEALTH DEPARTMENT

STATESVILLE 704-878-5305 CI MOORESVILLE 704-664-5281

IMPROVEMENT PERMIT / AUTHORIZATION TO CONSTRUCT / OPERATION PERMIT / EXISTING SYSTEM INSPECTION

PERMIT# 11371 9 PIN# 4860-64-7389 4860-64-7389 DATE 7-24-03

OWNER OR CONTRACTOR FLEETWOOD HOMES of STATESVILLE PHONE: Business 704-400-7019 Home 704-872-0179

ADDRESS 1270 NORTHSIDE DRIVE, STATESVILLE NC 28625

LOCATION US 21 NORTH, TL TABER ROAD, TR VALLEY SPRINGS DRIVE, 4th LOT ON LEFT

SUBDIVISION Holly Ridge BLOCK / SECTION II LOT 38 LOT AREA 0.73 ACRE SITE CLASS PS DESIGN FLOW 480 L.T.A.R. 0.30 GPD/FT²

Septic Tank: 1000 Gallons; STB 312 Date 8-25-03

Pump Tank: 1000 Gallons; PT 27 Date 8-11-03

Pump Make: MYERS Model YW50-11P Serial No. 2603D901

Nitrification Field: No Fields 1 Square Feet 1600 Linear Feet 540

No Lines SIX Trench Width 36" Max Trench Bottom Depth 36" Gravel Depth 12"

☑ New System ☐ Repair System Type: I, II, III, IV, V, VI

System Description: CONVENTIONAL PUMP

Repair System Description: CONVENTIONAL, PUMP

Maintenance Agreement Required: ☐ Yes ☐ No

☑ House/Mod. Home ☐ Mobile Home ☐ Business ☐ Other

No. Bedrooms 4 No. Bathrooms 2 No. Employees


☐ Slab ☑ Crawl Space ☐ Basement w/plumbing ☐ Basement wo/plumbing

Water Supply: ☐ Individual ☑ Public ☐ Community


Comments:/Conditions: SEE ATTACHED SHEETS FOR PUMP AND PRESSURE MANIFOLD REQUIREMENTS

Comments:/Conditions: LABEL FILTER & MARKER
√'D LINES & TANKS 9-17/9-18. NEEDS ELECTRICAL & PRESSURE
√'D ELECTRICAL; SEPTIC PUMP BREAKER ON OUTSIDE
SEPTIC ALARM BREAKER IS RECEPTACLE OUTLET IN LAUNDRY ROOM

INITIAL SITE SKETCH

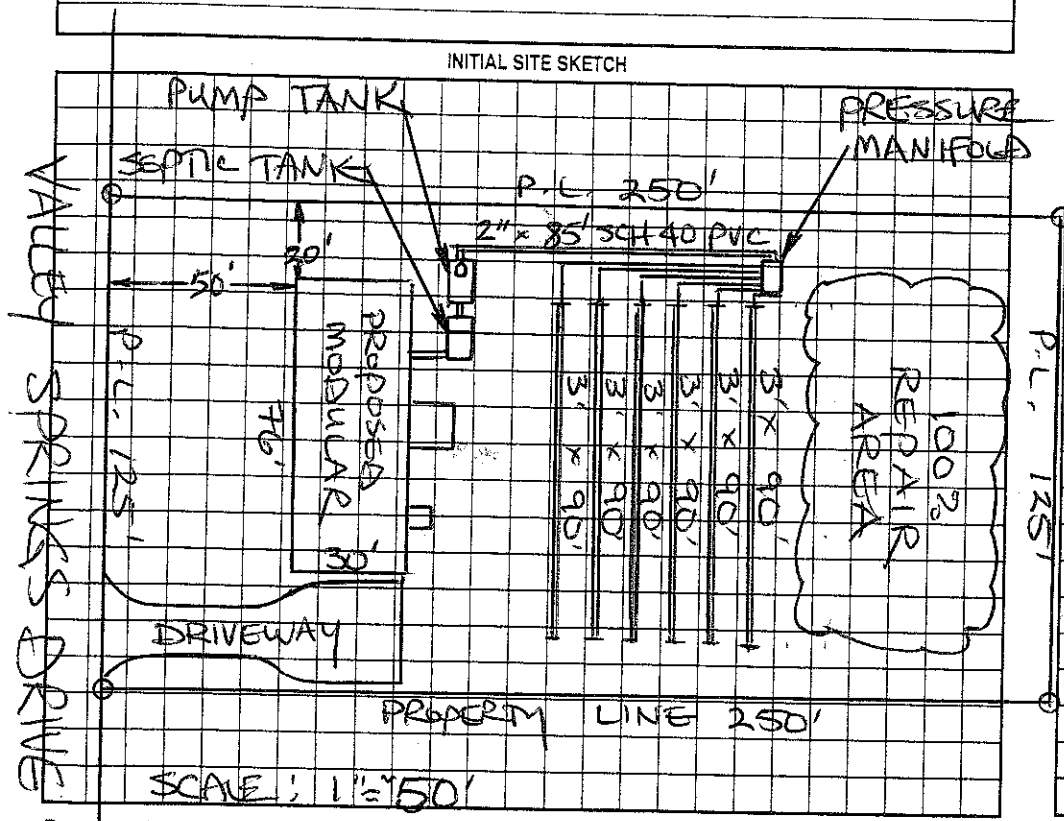

AS BUILT SKETCH

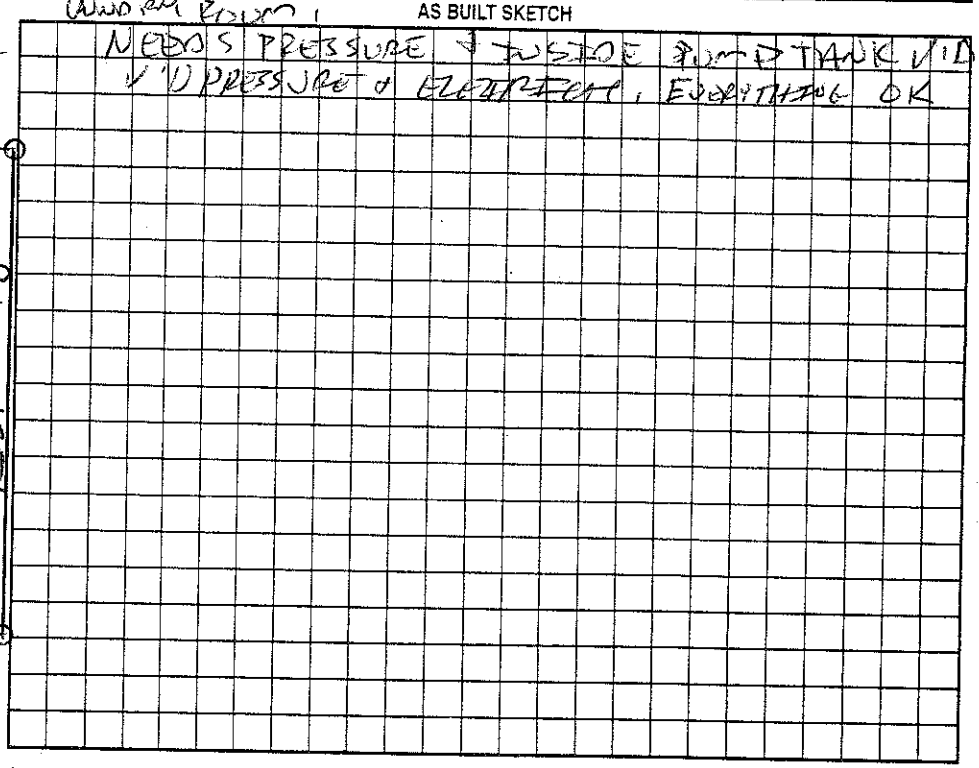

Permit can be suspended or revoked if any false information is supplied toward securing the permit/any unauthorized changes are made to the site/any unauthorized changes are made in the installation of the system. Improvement Permit with plat valid without expiration. Improvement Permit with site plan valid for sixty months. Authorization to Construct is valid for a period equal to that of Improvement Permit – not to exceed sixty months.

Signed: _____ date 7/31/03 Installed by: JAMES HUNDLEY

Improvement Permit by: STEVE HEDRICK date 7-24-03 Operation Permit by: _____ date 10-30-03

Authorization to Construct by: STEVE HEDRICK date 7-24-03 Existing System Inspection by: _____ date _____

HEALTH DEPT. COPY: WHITE OWNER COPY (FINAL): YELLOW OWNER COPY (INITIAL): PINK