IREDELL COUNTY HEALTH DEPARTMENT

STATESVILLE 704-878-5305 MOORESVILLE 704-664-5281

IMPROVEMENT PERMIT / AUTHORIZATION TO CONSTRUCT / OPERATION PERMIT / EXISTING SYSTEM INSPECTION

PERMIT# 091982 PIN# 4860 74 2322 (pt) DATE Sept. 25, 00

OWNER OR CONTRACTOR Sutherland Bld. PHONE: Business 528-0601 Home

ADDRESS P.O. Box 985 Troutman 28166

LOCATION From Statesville 21N TL TABOR RD. TR Valley Springs RD 4th Lt on Right

SUBDIVISION Holly Ridge BLOCK / SECTION LOT 37 LOT AREA .75 Ac SITE CLASS RS DESIGN FLOW 360 gpd L.T.A.R. .3

Septic Tank: 1000 Gallons; STB 1000 Date 9-27-00

Pump Tank: Gallons; PT Date

Pump Make: Model Serial No.

Nitrification Field: No Fields 1 Square Feet 1200 Linear Feet 400

No Lines 6 Trench Width 36" Max Trench Bottom Depth 36" Gravel Depth 12"

☑ New System ☐ Repair System Type: ☐ I ☐ II ☐ III ☐ IV

System Description: Gravity Conventional

Repair System Description: Conv. Pumped Innovative

Maintenance Agreement Required: ☐ Yes ☑ No

☐ House/Mod. Home No. Bedrooms 3

☐ Mobile Home No. Bathrooms 2 1/2

☐ Business No. Employees

☐ Other


☐ Slab ☑ Crawl Space ☐ Basement w/plumbing ☐ Basement wo/plumbing

Water Supply: ☐ Individual ☒ Public ☐ Community

Comments/Conditions: Follow contour w/ Laterals.

Comments/Conditions USED POLYLOK FILTER

INITIAL SITE SKETCH

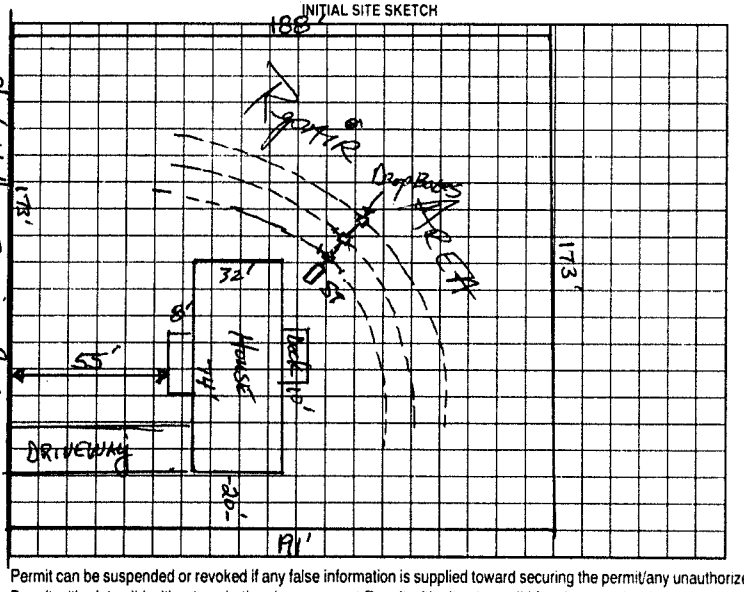

AS BUILT SKETCH

INSTALLED AS SHOWN WITH MARKER

RW Valley Springs Road

Permit can be suspended or revoked if any false information is supplied toward securing the permit/any unauthorized changes are made to the site/any unauthorized changes are made in the installation of the system. Improvement Permit with plat valid without expiration. Improvement Permit with site plan valid for sixty months. Authorization to Construct is valid for a period equal to that of Improvement Permit – not to exceed sixty months.

Signed: Sutherland Builders date 9-25-00 Installed by: TRAVIS ENTERPRISES

Improvement Permit by: [signature] RS date 9-25-00 Operation Permit by: [signature] RSI date 01-11-01

Authorization to Construct by: [signature] RS date 9-25-00 Existing System Inspection by: date

HEALTH DEPT COPY: WHITE OWNER COPY (FINAL) YELLOW OWNER COPY (INITIAL) PINK