IREDELL COUNTY HEALTH DEPARTMENT

STATESVILLE 704-878-5305 MOORESVILLE 704-664-5281

CI

IMPROVEMENT PERMIT / AUTHORIZATION TO CONSTRUCT / OPERATION PERMIT / EXISTING SYSTEM INSPECTION

PERMIT# 112471 PIN# 4860-64-9309 DATE 5-16-03

OWNER OR CONTRACTOR JOHNNY IRELAND PHONE: Business Home 704-546-2761

ADDRESS 136 HAYES ST, HARMONY, NC 28634

LOCATION US 21 N TL TABOR ROAD, TR VALLEY SPRINGS ROAD, 4TH & 5TH LOTS ON LEFT

SUBDIVISION Holly Ridge BLOCK / SECTION 2 LOT 39 & 40 LOT AREA 250' x 250' SITE CLASS. PS DESIGN FLOW 360 L.T.A.R. 0.30 gpd/ft²

Septic Tank: 1000 Gallons; STB 760 Date 3-16-03
Pump Tank: Gallons; PT Date
Pump Make: Model Serial No.
Nitrification Field: No Fields 1 Square Feet 1200 Linear Feet 400
No Lines FOUR Trench Width 36" Max Trench Bottom Depth 36" Gravel Depth 12"


☑ New System ☐ Repair System Type: I (II) III. IV. V. VI
System Description: CONVENTIONAL GRAVITY
Repair System Description: CONV. GRAVITY
Maintenance Agreement Required: ☐ Yes ☑ No

☑ House/Mod. Home No. Bedrooms 3
☐ Mobile Home No. Bathrooms 2
☐ Business No. Employees
☐ Other

☐ Slab ☑ Crawl Space ☐ Basement w/plumbing ☐ Basement wo/plumbing

Water Supply: ☑ Public ☐ Community

Comments:/Conditions:

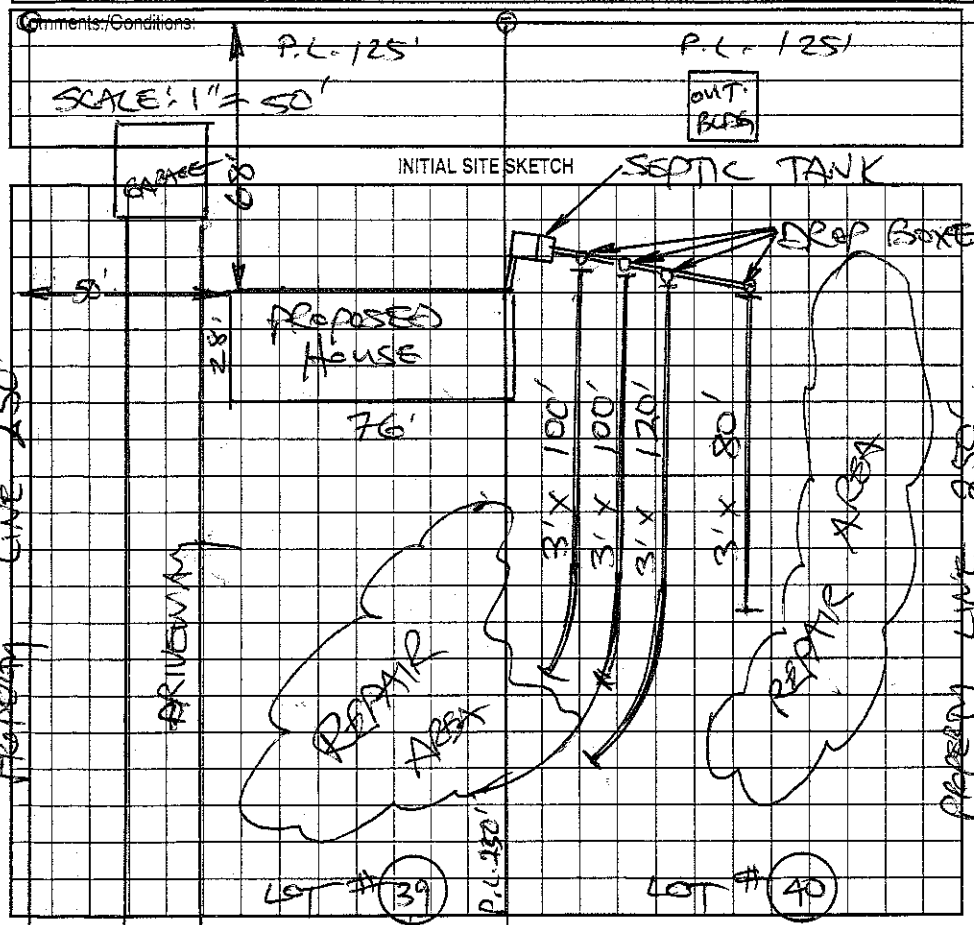

Comments:/Conditions: ZABEL FICTLE & MARKER INSTALLED AS DRAWN

AS BUILT SKETCH

(4)

Permit can be suspended or revoked if any false information is supplied toward securing the permit/any unauthorized changes are made to the site/any unauthorized changes are made in the installation of the system. Improvement Permit with plat valid without expiration. Improvement Permit with site plan valid for sixty months. Authorization to Construct is valid for a period equal to that of Improvement Permit – not to exceed sixty months.

Signed: Johnny Ireland date 5-16-03 Installed by: BRENT GALLIHER

Improvement Permit by: STEVE HENDRICK date 5-16-03 Operation Permit by: date 8-15-03

Authorization to Construct by: STEVE HENDRICK date 5-16-03 Existing System Inspection by: date

VALLEY SPRINGS ROAD

HEALTH DEPT. COPY: WHITE OWNER COPY (FINAL): YELLOW OWNER COPY (INITIAL): PINK