3.00

IREDELL COUNTY HEALTH DEPARTMENT

STATESVILLE 704-878-5305 MOORESVILLE 704-664-5281

IMPROVEMENT PERMIT / AUTHORIZATION TO CONSTRUCT / OPERATION PERMIT / EXISTING SYSTEM INSPECTION

PERMIT# 8960 PIN# 4860651207 DATE 6/13/00

OWNER OR CONTRACTOR RYAN BUILDERS PHONE: Business 878-9595 Home

ADDRESS 1281 GARNER GALNAL BLVD STATESVILLE NC 28677

LOCATION 77N- TR 70 MILEN MILL - TL TABOR CN RT PAST ASHFORD OR.

SUBDIVISION HAZELWOOD BLOCK / SECTION LOT 5 LOT AREA .69AC SITE CLASS IS DESIGN FLOW 360GPD L.T.A.R. .36 PD/FT²

Septic Tank: 1000 Gallons; STB 825 Date 6/18/00
Pump Tank: Gallons; PT Date
Pump Make: Model Serial No.
Nitrification Field: No Fields 1 Square Feet 1200 Linear Feet 400
No Lines 6@67' Trench Width 36" Max Trench Bottom Depth 36" Gravel Depth 12"

☑ New System ☐ Repair System Type: I, II, III, IV, V, VI
System Description: GRAVITY CONVENTIONAL
Repair System Description: OR PUMP SAME
Maintenance Agreement Required: ☐ Yes ☑ No


☑ House/Mod. Home No. Bedrooms 3
☐ Mobile Home No. Bathrooms 3
☐ Business No. Employees
☐ Other
☐ Slab ☑ Crawl Space ☐ Basement w/plumbing ☐ Basement wo/plumbing

Water Supply: ☐ Individual ☑ Public ☐ Community


Comments:/Conditions:
89½ 8 11 10 5 - 10
9½ 8 3 L
95½ - 8 10

Comments:/Conditions:

INITIAL SITE SKETCH 1" = 50'

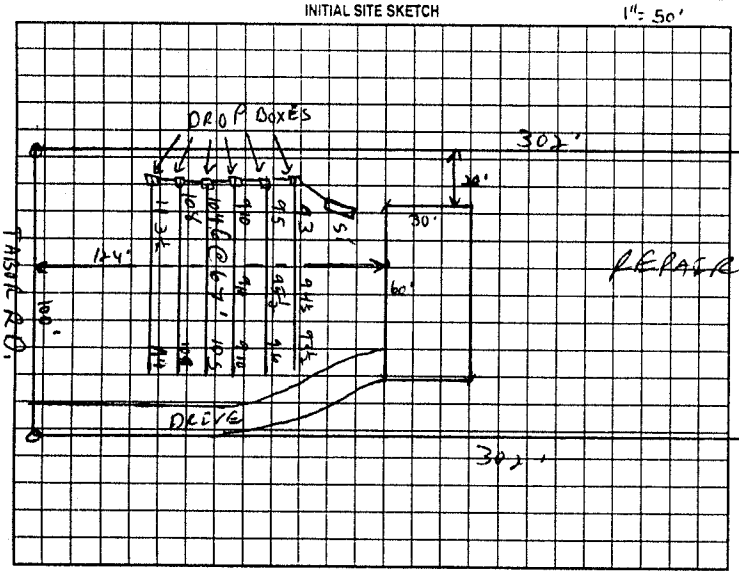

AS BUILT SKETCH

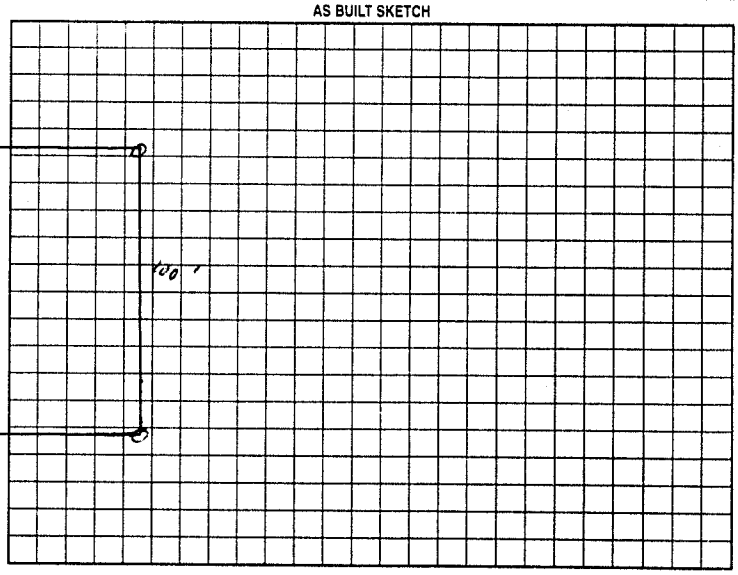

Permit can be suspended or revoked if any false information is supplied toward securing the permit/any unauthorized changes are made to the site/any unauthorized changes are made in the installation of the system. Improvement Permit with plat valid without expiration. Improvement Permit with site plan valid for sixty months. Authorization to Construct is valid for a period equal to that of Improvement Permit – not to exceed sixty months.

Signed: [signature] 6/14/2000 date

Installed by: UPRIGHT GRADING

Improvement Permit by: C. [signature] RS date 6/13/00

Operation Permit by: C. [signature] RS date 8/24/00

Authorization to Construct by: C. [signature] RS date 6/13/00

Existing System Inspection by: date

HEALTH DEPT. COPY: WHITE OWNER COPY (FINAL): YELLOW OWNER COPY (INITIAL): PINK