IREDELL COUNTY HEALTH DEPARTMENT

STATESVILLE 704-878-5305 MOORESVILLE 704-664-5281

IMPROVEMENT PERMIT / AUTHORIZATION TO CONSTRUCT / OPERATION PERMIT / EXISTING SYSTEM INSPECTION

PERMIT# 089925 PIN# 4860 74 2322 (PT) DATE 6-21-2000

OWNER OR CONTRACTOR DELRICK INABINETT PHONE: Business Home 876-6479

ADDRESS 153 KINGSDALE DRIVE, STATESVILLE, NC, 28625

LOCATION US 21 NORTH, TL TABOR ROAD, TR FORNEY ROAD, 2ND LOT ON LEFT

SUBDIVISION FORNEY ACRES BLOCK / SECTION LOT 1 LOT AREA 0.836 ACRE SITE CLASS PS DESIGN FLOW 360 L.T.A.R. 0.30 GPD/FT²

Septic Tank: 1000 Gallons; STB 1012 Date 6-11-00
Pump Tank: Gallons; PT Date
Pump Make: Model Serial No
Nitrification Field: No Fields 1 Square Feet 1200 Linear Feet 400
No Lines FIVE Trench Width 36" Max Trench Bottom Depth 36" Gravel Depth 12"

☒ New System ☐ Repair System Type: I II III IV V VI
System Description: CONVENTIONAL GRAVITY
Repair System Description: CONVENTIONAL PUMP
Maintenance Agreement Required: ☐ Yes ☑ No

☐ House/Mod. Home ☑ Mobile Home ☐ Business ☐ Other
No. Bedrooms 3 No. Bathrooms 2 No. Employees


☐ Slab ☑ Crawl Space ☐ Basement w/plumbing ☐ Basement wo/plumbing

Water Supply: ☐ Individual ☑ Public ☐ Community


Comments/Conditions: KEEP SYSTEM MINIMUM 20 FEET FROM PROPERTY LINE DUE TO UTILITY AND DRAINAGE EASEMENTS

Comments/Conditions: SEPTIC TANK W/ RISERS INSTALLED USING "POLYLOK" FILTER

INITIAL SITE SKETCH SCALE: 1"=40'

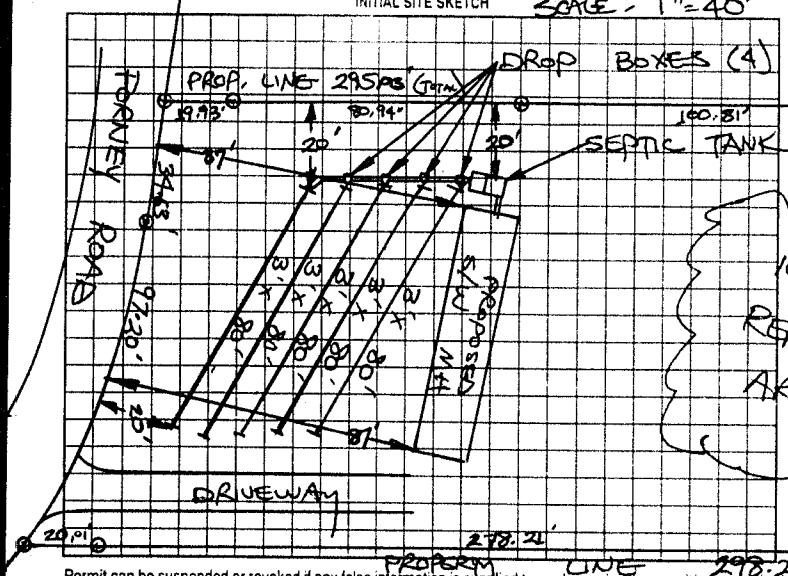

AS BUILT SKETCH

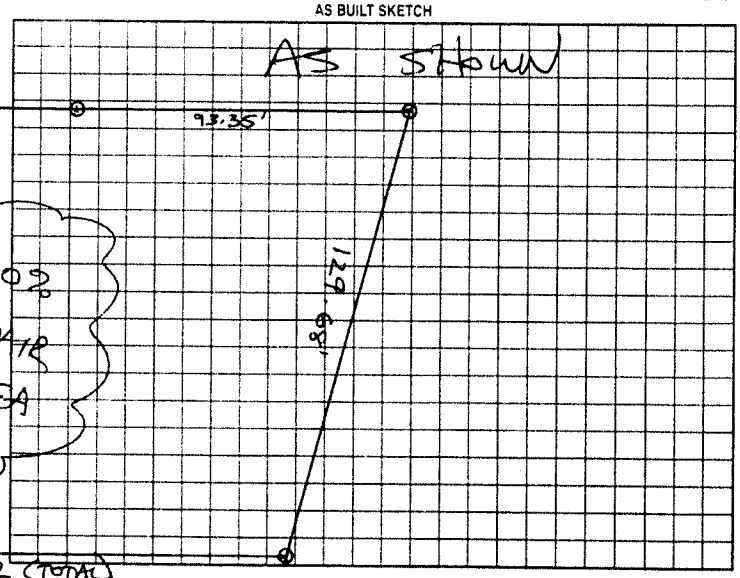

Permit can be suspended or revoked if any false information is supplied toward securing the permit/any unauthorized changes are made to the site/any unauthorized changes are made in the installation of the system. Improvement Permit with plan valid without expiration. Improvement Permit with site plan valid for sixty months. Authorization to Construct is valid for a period equal to that of Improvement Permit – not to exceed sixty months.

Signed: James Stadler date 6-21-00 Installed by: A-1 BACKHOE

Improvement Permit by: STEVE HEDRICK date 6-21-2000 Operation Permit by: STEVE HEDRICK date 8-22-00

Authorization to Construct by: STEVE HEDRICK date 6-21-200 Existing System Inspection by: date

HEALTH DEPT. COPY: WHITE OWNER COPY (FINAL): YELLOW OWNER COPY (INITIAL): PINK