IREDELL COUNTY HEALTH DEPARTMENT STATESVILLE 704-878-5305 MOORESVILLE 704-664-5281

IMPROVEMENT PERMIT / AUTHORIZATION TO CONSTRUCT / OPERATION PERMIT / EXISTING SYSTEM INSPECTION

PERMIT # 15382 PIN # 4860653686 DATE 10-31-08

OWNER or APPLICANT Joseph Blackledge PHONE: Business 704 924-9443 Home:

OWNER or APPLICANT ADDRESS 109 Shewin Lane

LOCATION / DIRECTIONS US21N, (L) on Tabor, (R) on Forney, 1st Rd, on (L) - Shewin Ln at end on (L)

SUBDIVISION Forney Acres BLOCK / SECTION LOT # 3 LOT AREA .74 DESIGN FLOW 360 L.T.A.R. .3

Septic Tank 1000 Gallons: STB 760 Date 7-21-08
Pump Tank Gallons: PT Date
Pump Make Model Serial #
Nitrification Field No Fields 1 No Lines 4 Linear Feet 300
Trench Width 36" Max. Trench Bottom Depth 36" Gravel Depth n/a

☒ New System ☐ Repair ☐ Expansion System Type I II III IV V VI
System Description: 25% Reduction Gravity ~~SP~~ Pump
Repair System Description: 25% Reduction
Maintenance Agreement Required ☐ YES ☒ NO
☒ GRAVITY ☐ PRESSURE


☒ Residence No. Bedrooms 3
☐ Business No. Persons
☐ Other No. Employees
☐ Slab ☒ Crawl Space
☐ Basement w/plumbing ☐ Basement w/o plumbing

Water Supply: ☒ Private ☐ Public ☐ Community


Comments / Conditions

Comments / Conditions

INITIAL SITE SKETCH

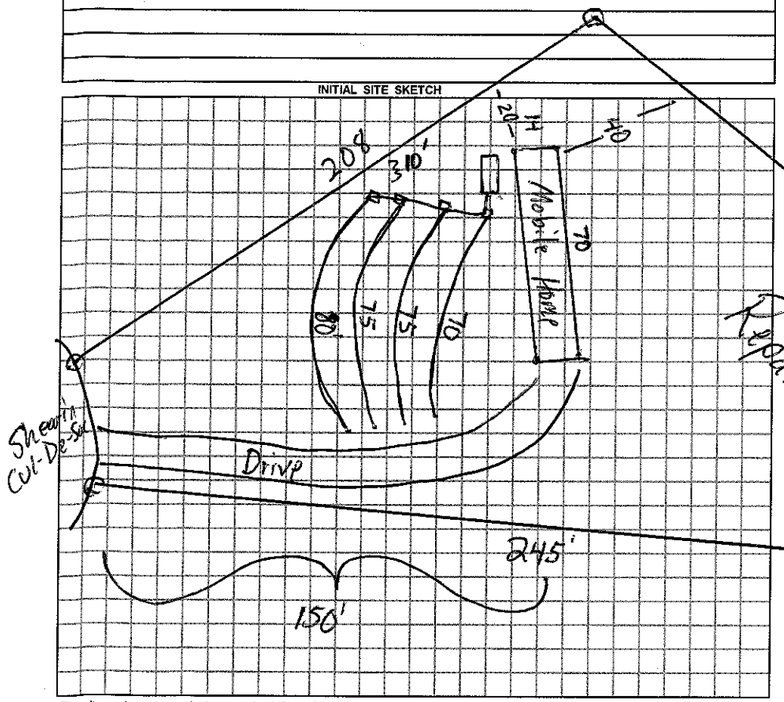

AS BUILT SKETCH

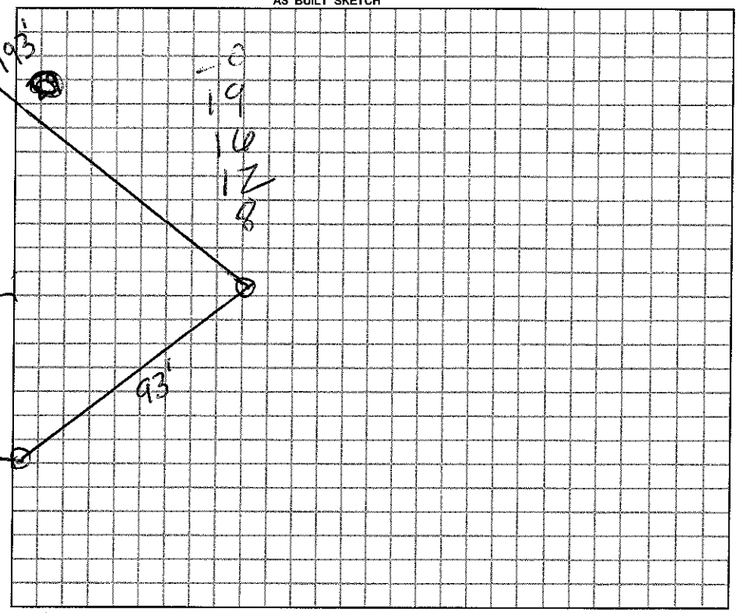

Permit can be suspended or revoked if any false information is supplied toward securing the permit / any unauthorized changes are made to the site / any unauthorized changes are made in the installation of the system.

☐ *IMPROVEMENT PERMIT w / plat valid without expiration.* ☒ *IMPROVEMENT PERMIT w / site plan valid for 60 mos.* ☒ *AUTHORIZATION TO CONSTRUCT valid for period equal to IMPROVEMENT PERMIT-not to exceed 60 mo.*

Owner / Applicant Signature: Joseph W Blackledge Date 10-31-08

Improvement Permit by: James Date 10-31-08

Authorzation to Construct by: James Date 10-31-08

YOU SHOULD CONTACT A LOCATOR SERVICE PRIOR TO ANY EXCAVATION.

Installed by: A-1 Backhoe

Operation Permit by: James Date: 12-16-08

Existing System Inspected by: Date:

WHITE COPY Environmental Health YELLOW COPY (Final) Owner / Applicant PINK COPY (Initial) Owner / Applicant