IREDELL COUNTY HEALTH DEPARTMENT

STATESVILLE 704-878-5305 MOORESVILLE 704-664-5281

IMPROVEMENT PERMIT / AUTHORIZATION TO CONSTRUCT / OPERATION PERMIT / EXISTING SYSTEM INSPECTION

PERMIT# 08945 PIN# 4860742322 (pt.) DATE August 21, 2000

OWNER OR CONTRACTOR James Small II Family Value Homes PHONE: Business 799-1560 Home

ADDRESS 2880 Charlotte Hwy Mooresville N.C. 28117

LOCATION I77 N Tomlin Mill Rd Exit TR TO END TL TABOR TR FORNEY TL SHEARIN ON left - CORNER LOT

SUBDIVISION Forney Acres BLOCK / SECTION LOT 2 LOT AREA .61 AC SITE CLASS PS DESIGN FLOW 360 gpd L.T.A.R. .3

Septic Tank: 1000 Gallons; STB 1012 Date 6-6-00
Pump Tank: Gallons; PT Date
Pump Make: Model Serial No.
Nitrification Field: No Fields 1 Square Feet 1200 Linear Feet 400
No Lines 4 Trench Width 36" Max Trench Bottom Depth 36" Gravel Depth 12"

☒ New System ☐ Repair System Type: I II III IV V VI
System Description: GRAVITY CONVENTIONAL
Repair System Description: GRAVITY INNOVATIVE-75%
Maintenance Agreement Required: ☐ Yes ☒ No Rec.


☒ House/Mod. Home No. Bedrooms 3
☐ Mobile Home No. Bathrooms 2
☐ Business No. Employees
☐ Other
☐ Slab ☒ Crawl Space ☐ Basement w/plumbing ☐ Basement wo/plumbing

Water Supply: ☐ Individual ☒ Public ☐ Community

Comments/Conditions: Follow contour As flagged

Comments/Conditions SEPTIC TANK W/ RISERS INSTALLED USING "POLY LOK" FILTER

INITIAL SITE SKETCH

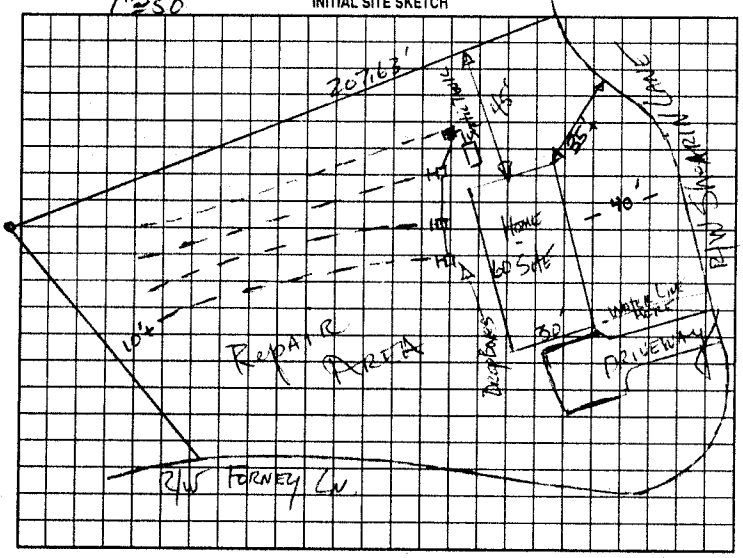

AS BUILT SKETCH

SYSTEM INSTALLED ACCORDING TO INITIAL SITE SKETCH

Permit can be suspended or revoked if any false information is supplied toward securing the permit/any unauthorized changes are made to the site/any unauthorized changes are made in the installation of the system. Improvement Permit with plat valid without expiration. Improvement Permit with site plan valid for sixty months. Authorization to Construct is valid for a period equal to that of Improvement Permit – not to exceed sixty months.

Signed: Dennis Dalton date 8-22-00 Installed by: A-1 BACKHOE

Improvement Permit by: [signature] date 8-21-00 Operation Permit by: STEVE HENRICK date 8-23-00

Authorization to Construct by: [signature] date 8-21-00 Existing System Inspection by: date

HEALTH DEPT. COPY: WHITE OWNER COPY (FINAL): YELLOW OWNER COPY (INITIAL): PINK