IREDELL COUNTY HEALTH DEPARTMENT - *ENVIRONMENTAL HEALTH* ☑ STATESVILLE OFFICE 704-878-5305 ☐ MOORESVILLE OFFICE 704-664-5281

IMPROVEMENT PERMIT / AUTHORIZATION TO CONSTRUCT / OPERATION PERMIT / EXISTING SYSTEM INSPECTION

PERMIT # 165141 PIN # 4860 65 6435 DATE Feb 23, 2011

OWNER Dawn Williams APPLICANT: PHONE: Home/Cell # 704 253 9078 Business #

SITE ADDRESS 137 Forney Rd, Statesville OWNER / APPLICANT ADDRESS

SITE DIRECTIONS Hwy 21 S to R Forney on left & just W/ Sherwin

SUBDIVISION Forney Acres BLOCK / SECTION LOT # 7 LOT AREA 1 ac DESIGN FLOW 360 gpd L.T.A.R.

Septic Tank Existing Gallons: STB Date

Pump Tank 1 Gallons: P T Date

Pump Make Model Serial #

No. Nitrification Fields: Existing No. Lines Linear Feet

Trench Width Existing Max. Trench Bottom Depth Gravel Depth

☐ New System ☐ Repair ☐ Expansion System Type I II (III) IV V VI

System Description: Existing

Repair System Description:

Maintenance Agreement Required ☐ YES ☐ NO

☑ GRAVITY ☐ PRESSURE

☑ Residence No. Bedrooms 2

☐ Business No. Persons

☐ Other No. Employees

☐ Slab ☑ Crawl Space


☐ Basement w/plumbing ☐ Basement w/o plumbing

Water Supply: ☐ Private ☑ Public ☐ Community

Comments / Conditions

Existing system OK @ time of inspection; Mobile home not on site. System designed for 3 bedrooms but 2 bedroom being set up at this time.

INITIAL SITE SKETCH

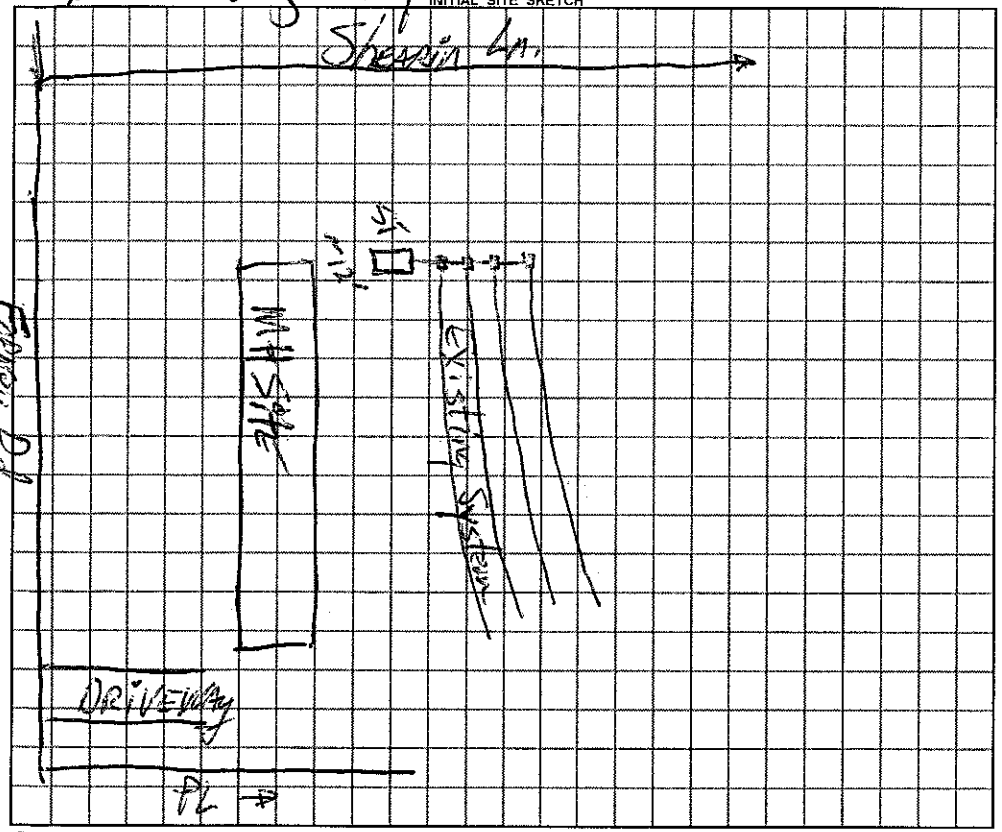

AS BUILT SKETCH

Permit can be suspended or revoked if any false information is supplied toward securing the permit / any unauthorized changes are made to the site / any unauthorized changes are made in the installation of the system.

☐ ***IMPROVEMENT PERMIT*** with plat valid without expiration. ☐ ***IMPROVEMENT PERMIT*** with plat valid without expiration. ☐ ***AUTHORIZATION TO CONSTRUCT*** valid for period equal to IMPROVEMENT PERMIT--not to exceed 60 mo.

Owner / Applicant Signature: Date 2-23-11 Installed by:

IMPROVEMENT PERMIT by: REHS Date OPERATION PERMIT by: REHS Date

AUTHORIZATION TO CONSTRUCT by: REHS Date Existing System Inspected by: REHS Date 2-23-11

YOU SHOULD CONTACT A LOCATOR SERVICE PRIOR TO ANY EXCAVATION

White Copy – Environmental Health YELLOW COPY (Final) Owner / Applicant PINK COPY (Initial) Owner / Applicant